

NOTES  
-ALL STORMWATER PIPES ARE RCP "3" U.N.O

**Works As Constructed**  
It is certified that the locations, Levels and dimensions of the infrastructure shown herein are a true representation of the constructed works and that the As-Constructed survey was performed to the prescribed accuracy standards.

Authorised Delegate..... *C. Walters*  
Date..... 20/11/2019.....  
LandPartners Pty Ltd (ACN I18 146 008) Surveyor No. S4118

**Works As Constructed**  
It is certified that works herein have been constructed to Local Government standards, relevant approved specifications and the operational works approval. The As-Constructed Drawings for these works constitutes a true and correct record of the works constructed and complies with the design intent.

Signature.....RPEQ No.....  
Date of Practical Completion.....  
Engineering Consultant.....

**A1**

ISSUE	DATE	AUTHOR	COMMENTS	ISSUE	DATE	AUTHOR	COMMENTS
1	16/11/2019	BJB	INITIAL ISSUE				
2	20/11/2019	BJB	DRAFTING AMENDMENT				



**Brisbane Office**  
Level 1,  
28 Little Collins Street,  
Melbourne, VIC, 3000  
PO Box 1399  
1 (07) 3842 1000  
e info@landpartners.com.au  
www.landpartners.com.au

CLIENT  
**ORCHARD DEVELOPMENTS PTY LTD**


PROJECT  
**PEBBLE CREEK  
STAGE 1 & ENTRY ROAD  
AS CONSTRUCTED STORMWATER**

ENGINEERING CONSULTANT  
**PEAK URBAN PTY LTD**

LGA/SERVICE PROVIDER  
**ECONOMIC DEVELOPMENT QUEENSLAND**

SCALE 1:500

SHEET			1 of 2		
DATUM	AHD	LEVEL ORIGIN			
CONTOURS	N/A	FILE NO.	BRSS7455-001-80-2		
DRAWN	BJB	DATE	20/11/2019		
CHECKED	RA	DATE	20/11/2019		
APPROVED	RA	DATE	20/11/2019		
PLAN NUMBER	<b>BRSS7455-001-81-2</b>				

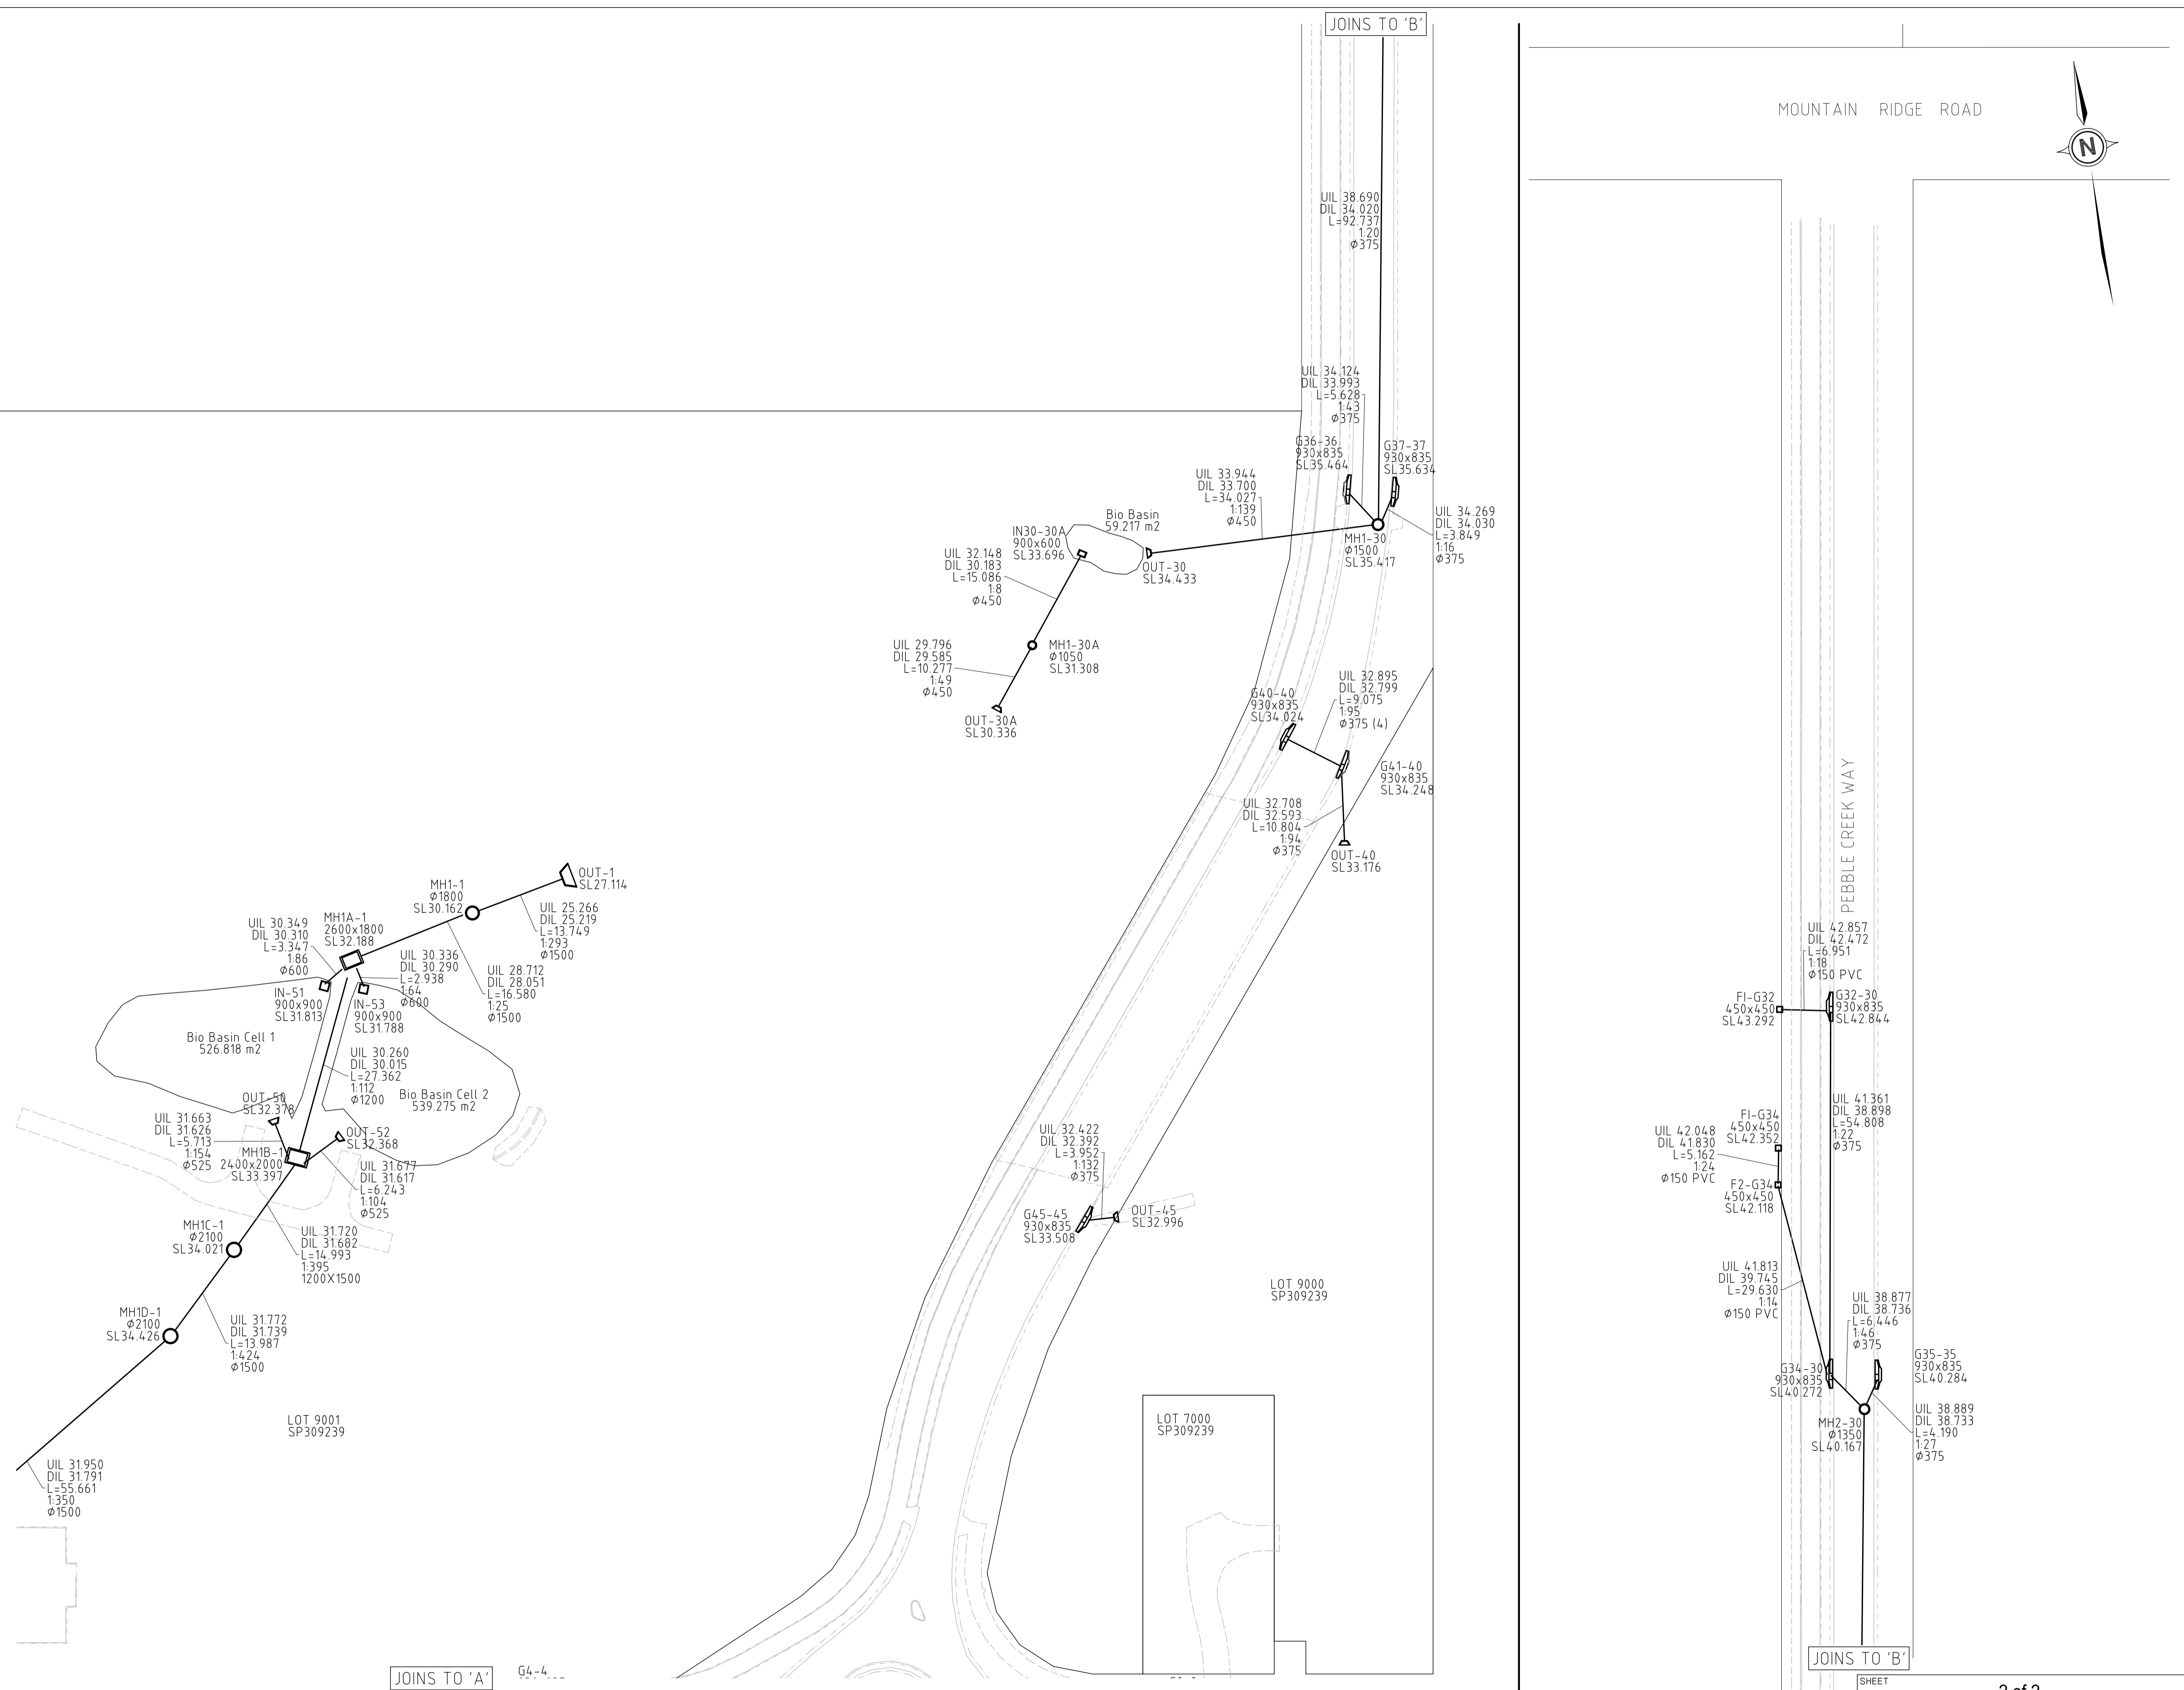

NOTES  
-ALL STORMWATER PIPES ARE RCP "3" U.N.O.

**Works As Constructed**  
It is certified that the locations, Levels and dimensions of the infrastructure shown herein are a true representation of the constructed works and that the As-Constructed survey was performed to the prescribed accuracy standards.

Authorised Delegate: *C. Walters*  
Date: 20/11/2019  
LandPartners Pty Ltd (ACN I18 146 008) Surveyor No. S4118

**Works As Constructed**  
It is certified that works herein have been constructed to Local Government standards, relevant approved specifications and the operational works approval. The As-Constructed Drawings for these works constitutes a true and correct record of the works constructed and complies with the design intent.

Signature: \_\_\_\_\_ RPEQ No. \_\_\_\_\_  
Date of Practical Completion: \_\_\_\_\_  
Engineering Consultant: \_\_\_\_\_

**A1**

ISSUE	DATE	AUTHOR	COMMENTS	ISSUE	DATE	AUTHOR	COMMENTS
1	16/11/2019	BJB	INITIAL ISSUE				
2	20/11/2019	BJB	DRAFTING AMENDMENT				



**Brisbane Office**  
Level 1,  
25 Little Collins Street,  
Melbourne, VIC, 3000  
PO Box 1399  
1 (07) 3842 1000  
1 (07) 3842 1001  
e info@landpartners.com.au  
www.landpartners.com.au

CLIENT  
**ORCHARD DEVELOPMENTS PTY LTD**

PROJECT  
**PEBBLE CREEK  
STAGE 1 & ENTRY ROAD  
AS CONSTRUCTED STORMWATER**

ENGINEERING CONSULTANT  
**PEAK URBAN PTY LTD**

LGA/SERVICE PROVIDER  
**ECONOMIC DEVELOPMENT QUEENSLAND**

SCALE 1:500

SHEET **2 of 2**

DATUM	AHD	LEVEL ORIGIN
CONTOURS	N/A	FILE NO. BRSS7455-001-80-2
DRAWN	BJB	DATE 20/11/2019
CHECKED	RA	DATE 20/11/2019
APPROVED	RA	DATE 20/11/2019
PLAN NUMBER	<b>BRSS7455-001-81-2</b>	