

NOTES
 -ALL SEWER MAIN PIPES ARE uPVC SN8 U.N.O.
 -ALL SEWER MAIN PIPES ARE #150 U.N.O.
 -ALL SEWER HOUSE CONNECTION PIPES ARE #100 uPVC SN6 U.N.O.

Works As Constructed
 It is certified that the locations, Levels and dimensions of the infrastructure shown herein are a true representation of the constructed works and that the As-Constructed survey was performed to the prescribed accuracy standards.

Authorised Delegate... *C. Walters*
 Date... **27/11/2019**
 LandPartners Pty Ltd (ACN I18 146 008) Surveyor No. S4118

Works As Constructed
 It is certified that works herein have been constructed to Local Government standards, relevant approved specifications and the operational works approval. The As-Constructed Drawings for these works constitutes a true and correct record of the works constructed and complies with the design intent.

Signature... *Troy Schultz* RPEQ No. **20631**
 Date of Practical Completion... **22/10/2019**
 Engineering Consultant... **Troy Schultz - PEAKURBAN**

LOT 9001
 SP309239

LOT 9000
 SP309239

LOT 7000
 SP309239

PS-1
 #3200
 SL 33.558

PUMP STATION

A1


ISSUE	DATE	AUTHOR	COMMENTS
1	27/11/2019	BJB	INITIAL ISSUE
2	27/11/2019	BJB	AMENDED ISSUE



Brisbane Office
 Level 1,
 25 Little Collins Street,
 Milton, QLD, 4064
 PO Box 1399
 1 (07) 3842 1000
 e info@landpartners.com.au
 www.landpartners.com.au

CLIENT **ORCHARD DEVELOPMENTS PTY LTD**
 PROJECT **PEBBLE CREEK STAGE 1 & ENTRY ROAD AS CONSTRUCTED SEWER**

ENGINEERING CONSULTANT **PEAK URBAN PTY LTD**
 LGA/SERVICE PROVIDER **ECONOMIC DEVELOPMENT QUEENSLAND**

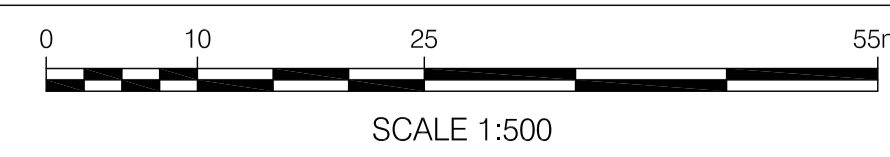

SHEET 2 of 2		
DATUM	AHD	LEVEL ORIGIN -
CONTOURS	N/A	FILE NO. BRSS7455-001-80-3
DRAWN	BJB	DATE 27/11/2019
CHECKED	RA	DATE 27/11/2019
APPROVED	RA	DATE 27/11/2019
PLAN NUMBER BRSS7455-001-83-2		