

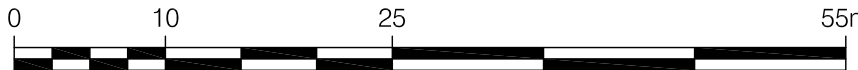
A1	ISSUE	DATE	AUTHOR	COMMENTS	ISSUE	DATE	AUTHOR	COMMENTS
	1	27/11/2019	BJB	INITIAL ISSUE				



Brisbane Office
Level 1,
18 Little Cribbs Street,
Milton, QLD, 4064
PO Box 1399
1 (07) 3842 1000
e info@landpartners.com.au
w www.landpartners.com.au


PE 300000000
15/03/2019

CLIENT	ORCHARD DEVELOPMENTS PTY LTD
PROJECT	PEBBLE CREEK STAGE 1 & ENTRY ROAD AS CONSTRUCTED WATER

ENGINEERING CONSULTANT	PEAK URBAN PTY LTD
LGA/SERVICE PROVIDER	ECONOMIC DEVELOPMENT QUEENSLAND
 SCALE 1:500	

SHEET			2 of 2
DATUM	AHD	LEVEL ORIGIN	-
CONTOURS	N/A	FILE NO.	BRSS7455-001-80-3
DRAWN	BJB	DATE	27/11/2019
CHECKED	RA	DATE	27/11/2019
APPROVED	RA	DATE	27/11/2019
PLAN NUMBER		BRSS7455-001-84-1	