

Works As Constructed

It is certified that the locations, Levels and dimensions of the infrastructure shown herein are a true representation of the constructed works and that the As-Constructed survey was performed to the prescribed accuracy standards.

Authorized Delegate.....*Rosa McDowall*.....(Director)

Date.....05/07/2022.....

LandPartners Pty Ltd (ACN I18 146 008) Surveyor No. S4118

Works As Constructed

It is certified that works herein have been constructed to Local Government standards, relevant approved specifications and the operational works approval. The As-Constructed Drawings for these works constitutes a true and correct record of the works constructed and complies with the design intent.


Signature.....*[Signature]*.....RPEQ No.....20631.....

Date of Practical Completion.....

Engineering **Troy Schultz**
Consultant.....

NOTES

- ALL SEWER RETICULATION PIPES ARE Ø150 uPVC S8 U.N.O.
- ALL SEWER HOUSE CONNECTION PIPES ARE Ø100 uPVC S6 U.N.O.
- SURFACE LEVEL FOR MS5-41 IS FROM DESIGN.

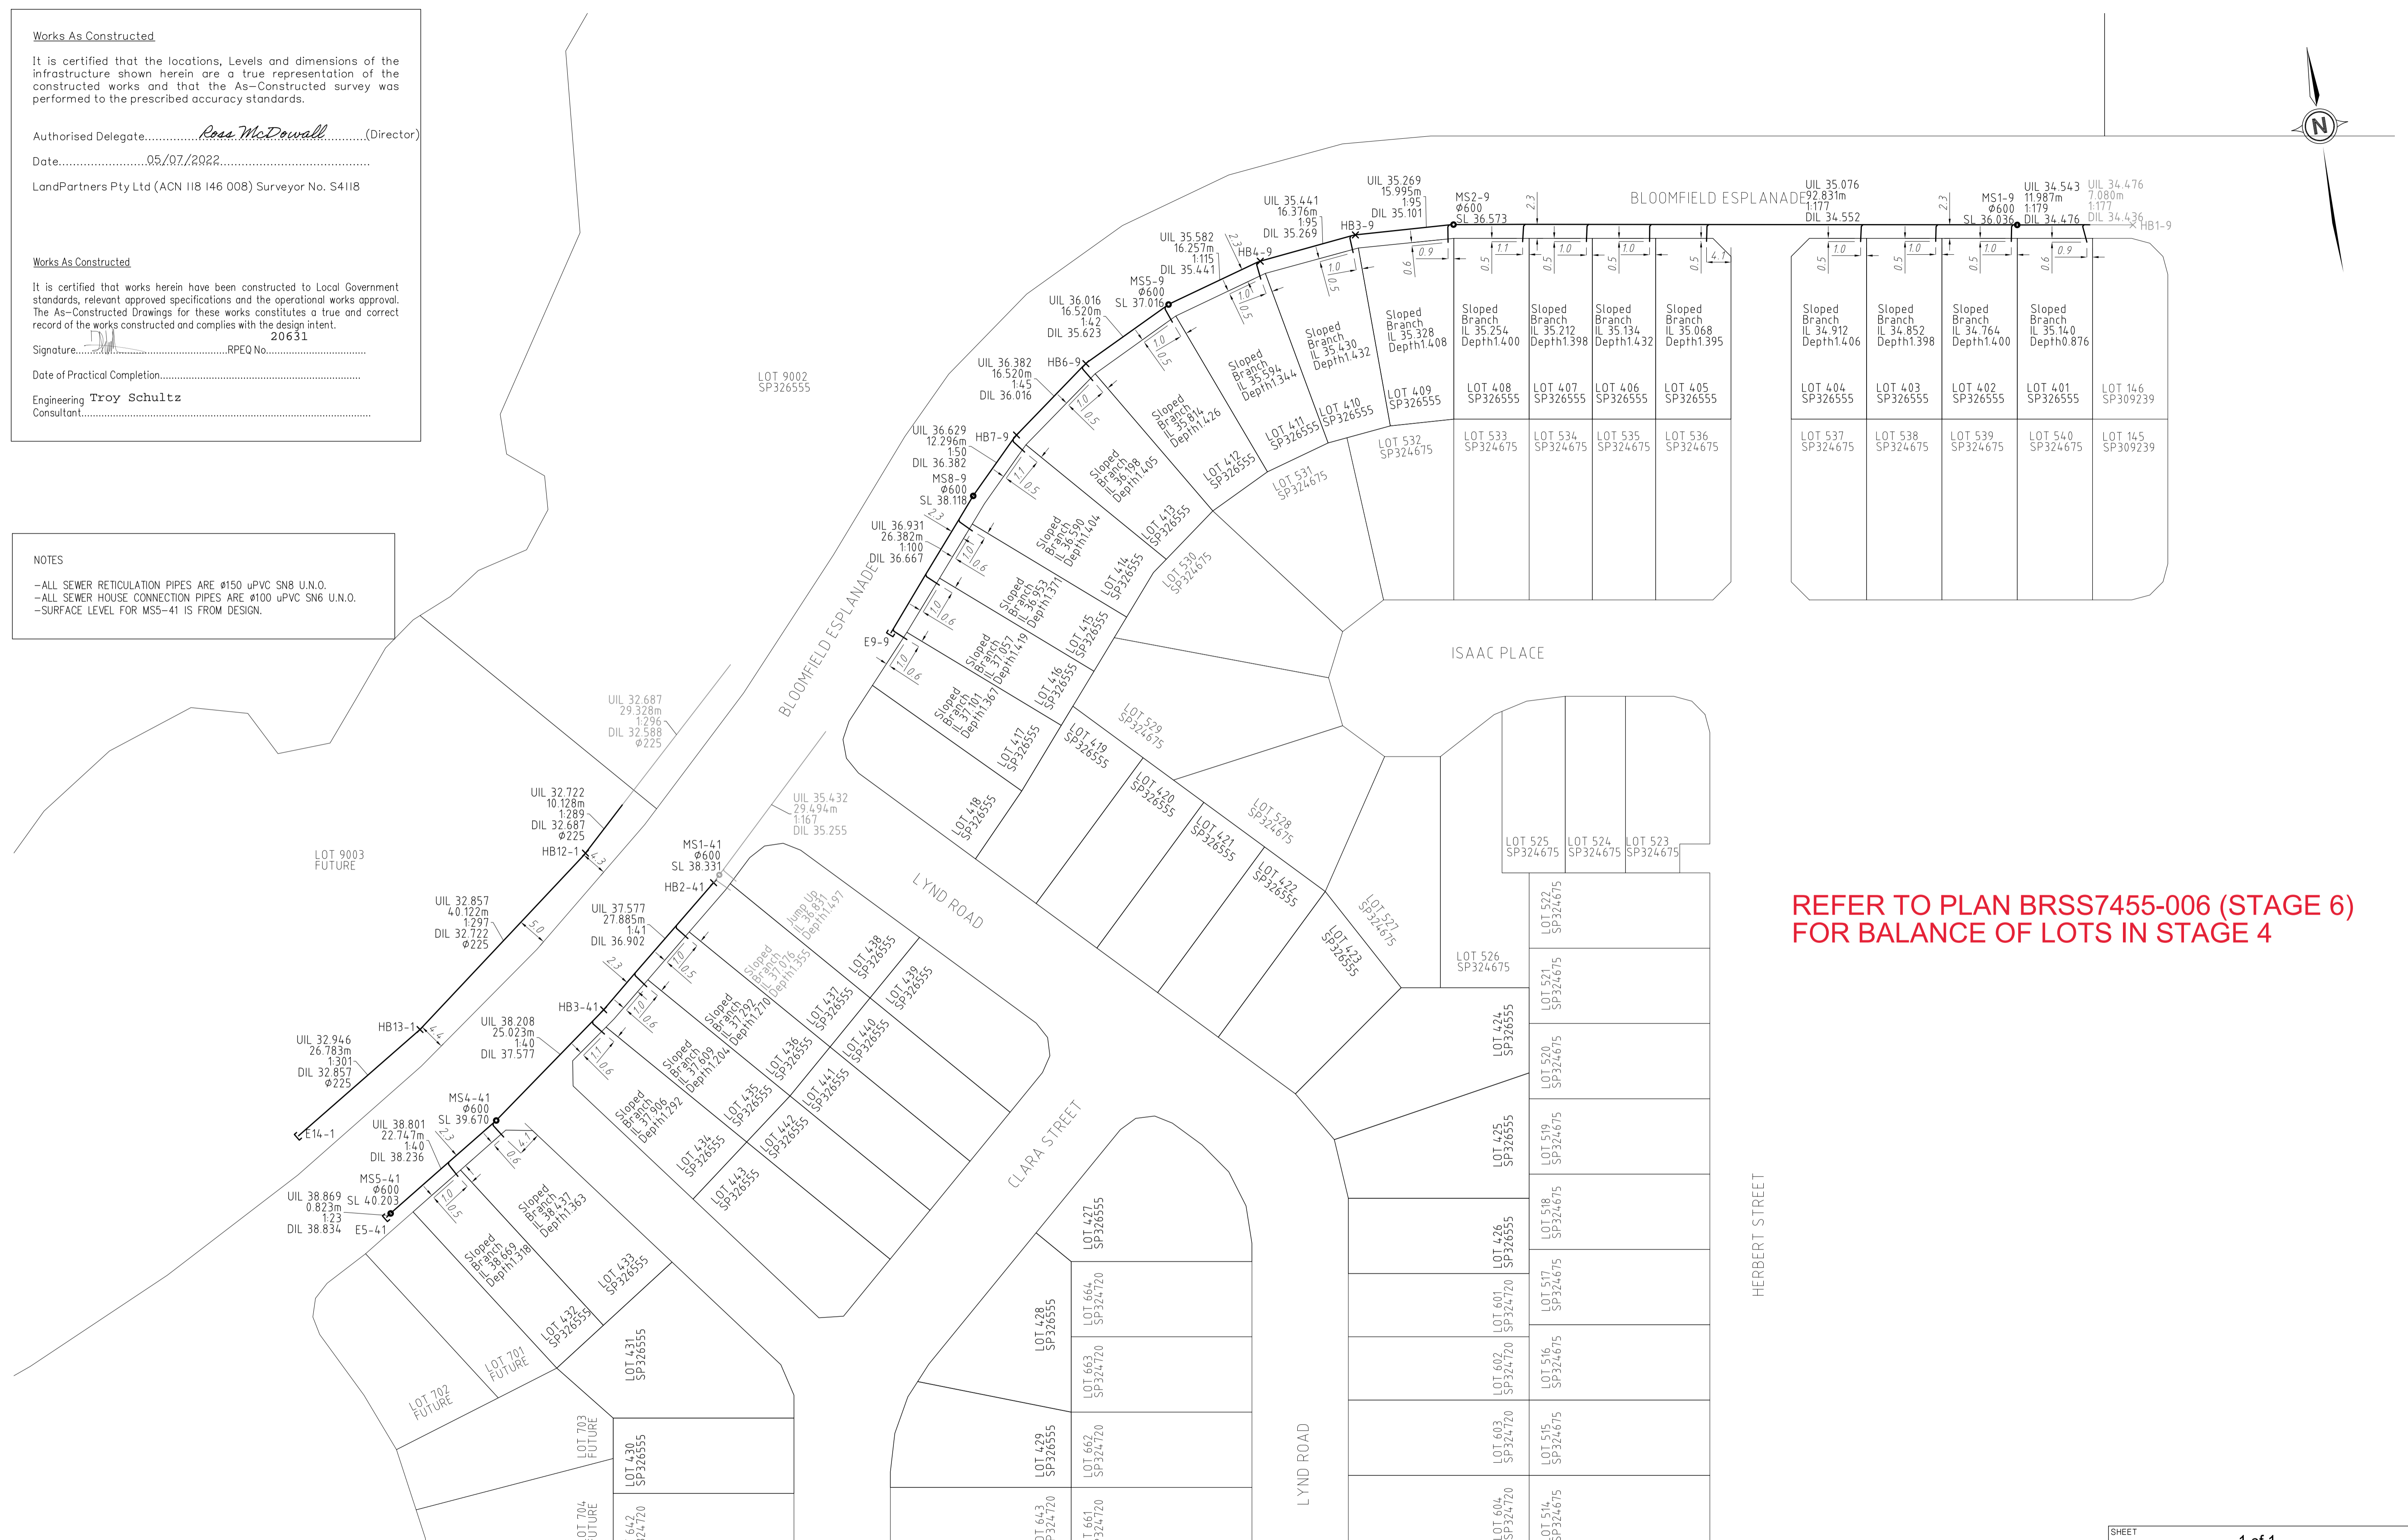

REFER TO PLAN BRSS7455-006 (STAGE 6) FOR BALANCE OF LOTS IN STAGE 4

| ISSUE | DATE | AUTHOR | COMMENTS | ISSUE | DATE | AUTHOR | COMMENTS |
|-------|------------|--------|---------------|-------|------|--------|----------|
| 1 | 05/07/2022 | BJB | INITIAL ISSUE | | | | |



Brisbane Office
Level 1,
28 Little Collins Street,
Milton, QLD, 4064
PO Box 1399
1 (07) 3842 1000
1 (07) 3842 1001
e info@landpartners.com.au
www.landpartners.com.au

CLIENT
ORCHARD DEVELOPMENT QUEENSLAND

PROJECT
**PEBBLE CREEK
STAGE 4
AS CONSTRUCTED SEWER
DEV2017/887/32**

ENGINEERING CONSULTANT
PEAK URBAN PTY LTD

LGA/SERVICE PROVIDER
ECONOMIC DEVELOPMENT QUEENSLAND

SCALE 1:500

| | | | |
|-------------|-------------------|--------------|-------------------|
| SHEET | 1 of 1 | | |
| DATUM | AHD | LEVEL ORIGIN | - |
| CONTOURS | N/A | FILE NO. | BRSS7455-004-71-1 |
| DRAWN | BJB | DATE | 05/07/2022 |
| CHECKED | RA | DATE | 05/07/2022 |
| APPROVED | RA | DATE | 05/07/2022 |
| PLAN NUMBER | BRSS7455-004-72-1 | | |

A1