

**NOTES**

- HOUSE CONNECTIONS LABELED 'CALC' HAVE SURFACE LEVELS DERIVED FROM DESIGN TIN.
- ALL SEWER RETICULATION PIPES ARE Ø150 uPVC SN8 U.N.O.
- ALL SEWER HOUSE CONNECTION PIPES ARE Ø100 uPVC SN6 U.N.O.

**Works As Constructed**


It is certified that the locations, Levels and dimensions of the infrastructure shown herein are a true representation of the constructed works and that the As-Constructed survey was performed to the prescribed accuracy standards.

Authorised Delegate.....*[Signature]*.....(Director)  
 Date.....25/08/2022.....  
 LandPartners Pty Ltd (ACN I18 146 008) Surveyor No. S4118

**Works As Constructed**

It is certified that works herein have been constructed to Local Government standards, relevant approved specifications and the operational works approval. The As-Constructed Drawings for these works constitutes a true and correct record of the works constructed and complies with the design intent.

Signature.....*[Signature]*.....RPEQ No.....  
 Date of Practical Completion.....  
 Engineering Consultant.....

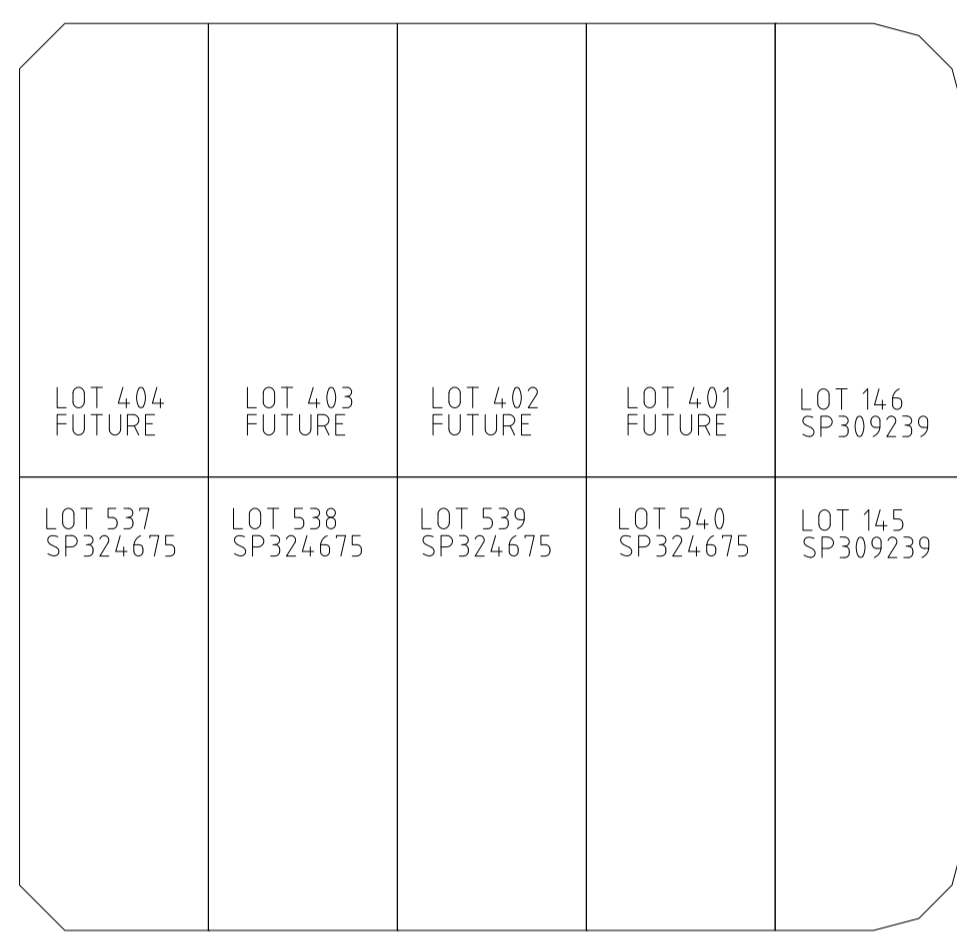

**A1**

ISSUE	DATE	AUTHOR	COMMENTS	ISSUE	DATE	AUTHOR	COMMENTS
1	30/11/2021	BJB	INITIAL ISSUE				
2	02/02/2022	BJB	AMEND STRUCTURE NAMES				
3	08/03/2022	BJB	ADD HOUSE CONNECTION FOR LOT612				
4	25/08/2022	BJB	DRAFTING AMENDMENT				



**Brisbane Office**  
 Level 1,  
 25 Little Collins Street,  
 Milton, QLD, 4064  
 PO Box 1399  
 1 (07) 3842 1000  
 e info@landpartners.com.au  
 www.landpartners.com.au

CLIENT **ORCHARD DEVELOPMENTS PTY LTD**

PROJECT **PEBBLE CREEK STAGE 6 AS CONSTRUCTED SEWER DEV2017/887**

ENGINEERING CONSULTANT **PEAK URBAN PTY LTD**

LGA/SERVICE PROVIDER **ECONOMIC DEVELOPMENT QUEENSLAND**

SCALE 1:500

SHEET <b>2 of 2</b>		
DATUM	AHD	LEVEL ORIGIN
CONTOURS	N/A	FILE NO. BRSS7455-006-83-5
DRAWN	BJB	DATE 25/08/2022
CHECKED	RA	DATE 25/08/2022
APPROVED	RA	DATE 25/08/2022
PLAN NUMBER <b>BRSS7455-006-84-4</b>		