

LEGEND

●	(FH) FIRE HYDRANT
⊗	(VS) STOP VALVE
✕	(VA) SCOUR ASSEMBLY
□	(TB) TAPPING BAND
×	(WM) WATER METER (SEQ 20φ)
⌋	END CAP
⊥	TEE
^	(RE) REDUCER
○	BEND
—	DICL WATER MAIN CROSSING
----	CONDUIT/CROSSING
---	EXISTING WATER

NOTES

- ALL WATER METERS AND SERVICE PIPES ARE AS PER DESIGN
- ALL FIRE HYDRANTS ARE φ100 SPRING U.N.O.
- ALL WATER MAIN PIPES ARE PVC-M PN16 U.N.O.
- ALL WATER MAIN CROSSING PIPES ARE DICL PN35 U.N.O.
- ALL SERVICE CROSSING CONDUITS ARE φ100 uPVC PN9 U.N.O.
- SERVICE CONNECTIONS TO LOTS 612 & 613 HAVE BEEN PROVIDED AS PART OF THE STAGE 3 WORKS

Works As Constructed

It is certified that the locations, Levels and dimensions of the infrastructure shown herein are a true representation of the constructed works and that the As-Constructed survey was performed to the prescribed accuracy standards.

Authorised Delegate.....*R.D. [Signature]*.....(Director)

Date.....25/08/2022.....

LandPartners Pty Ltd (ACN I18 146 008) Surveyor No. S4118


Works As Constructed

It is certified that works herein have been constructed to Local Government standards, relevant approved specifications and the operational works approval. The As-Constructed Drawings for these works constitutes a true and correct record of the works constructed and complies with the design intent.

Signature.....*[Signature]*.....RPEQ No.....

Date of Practical Completion.....

Engineering Consultant.....

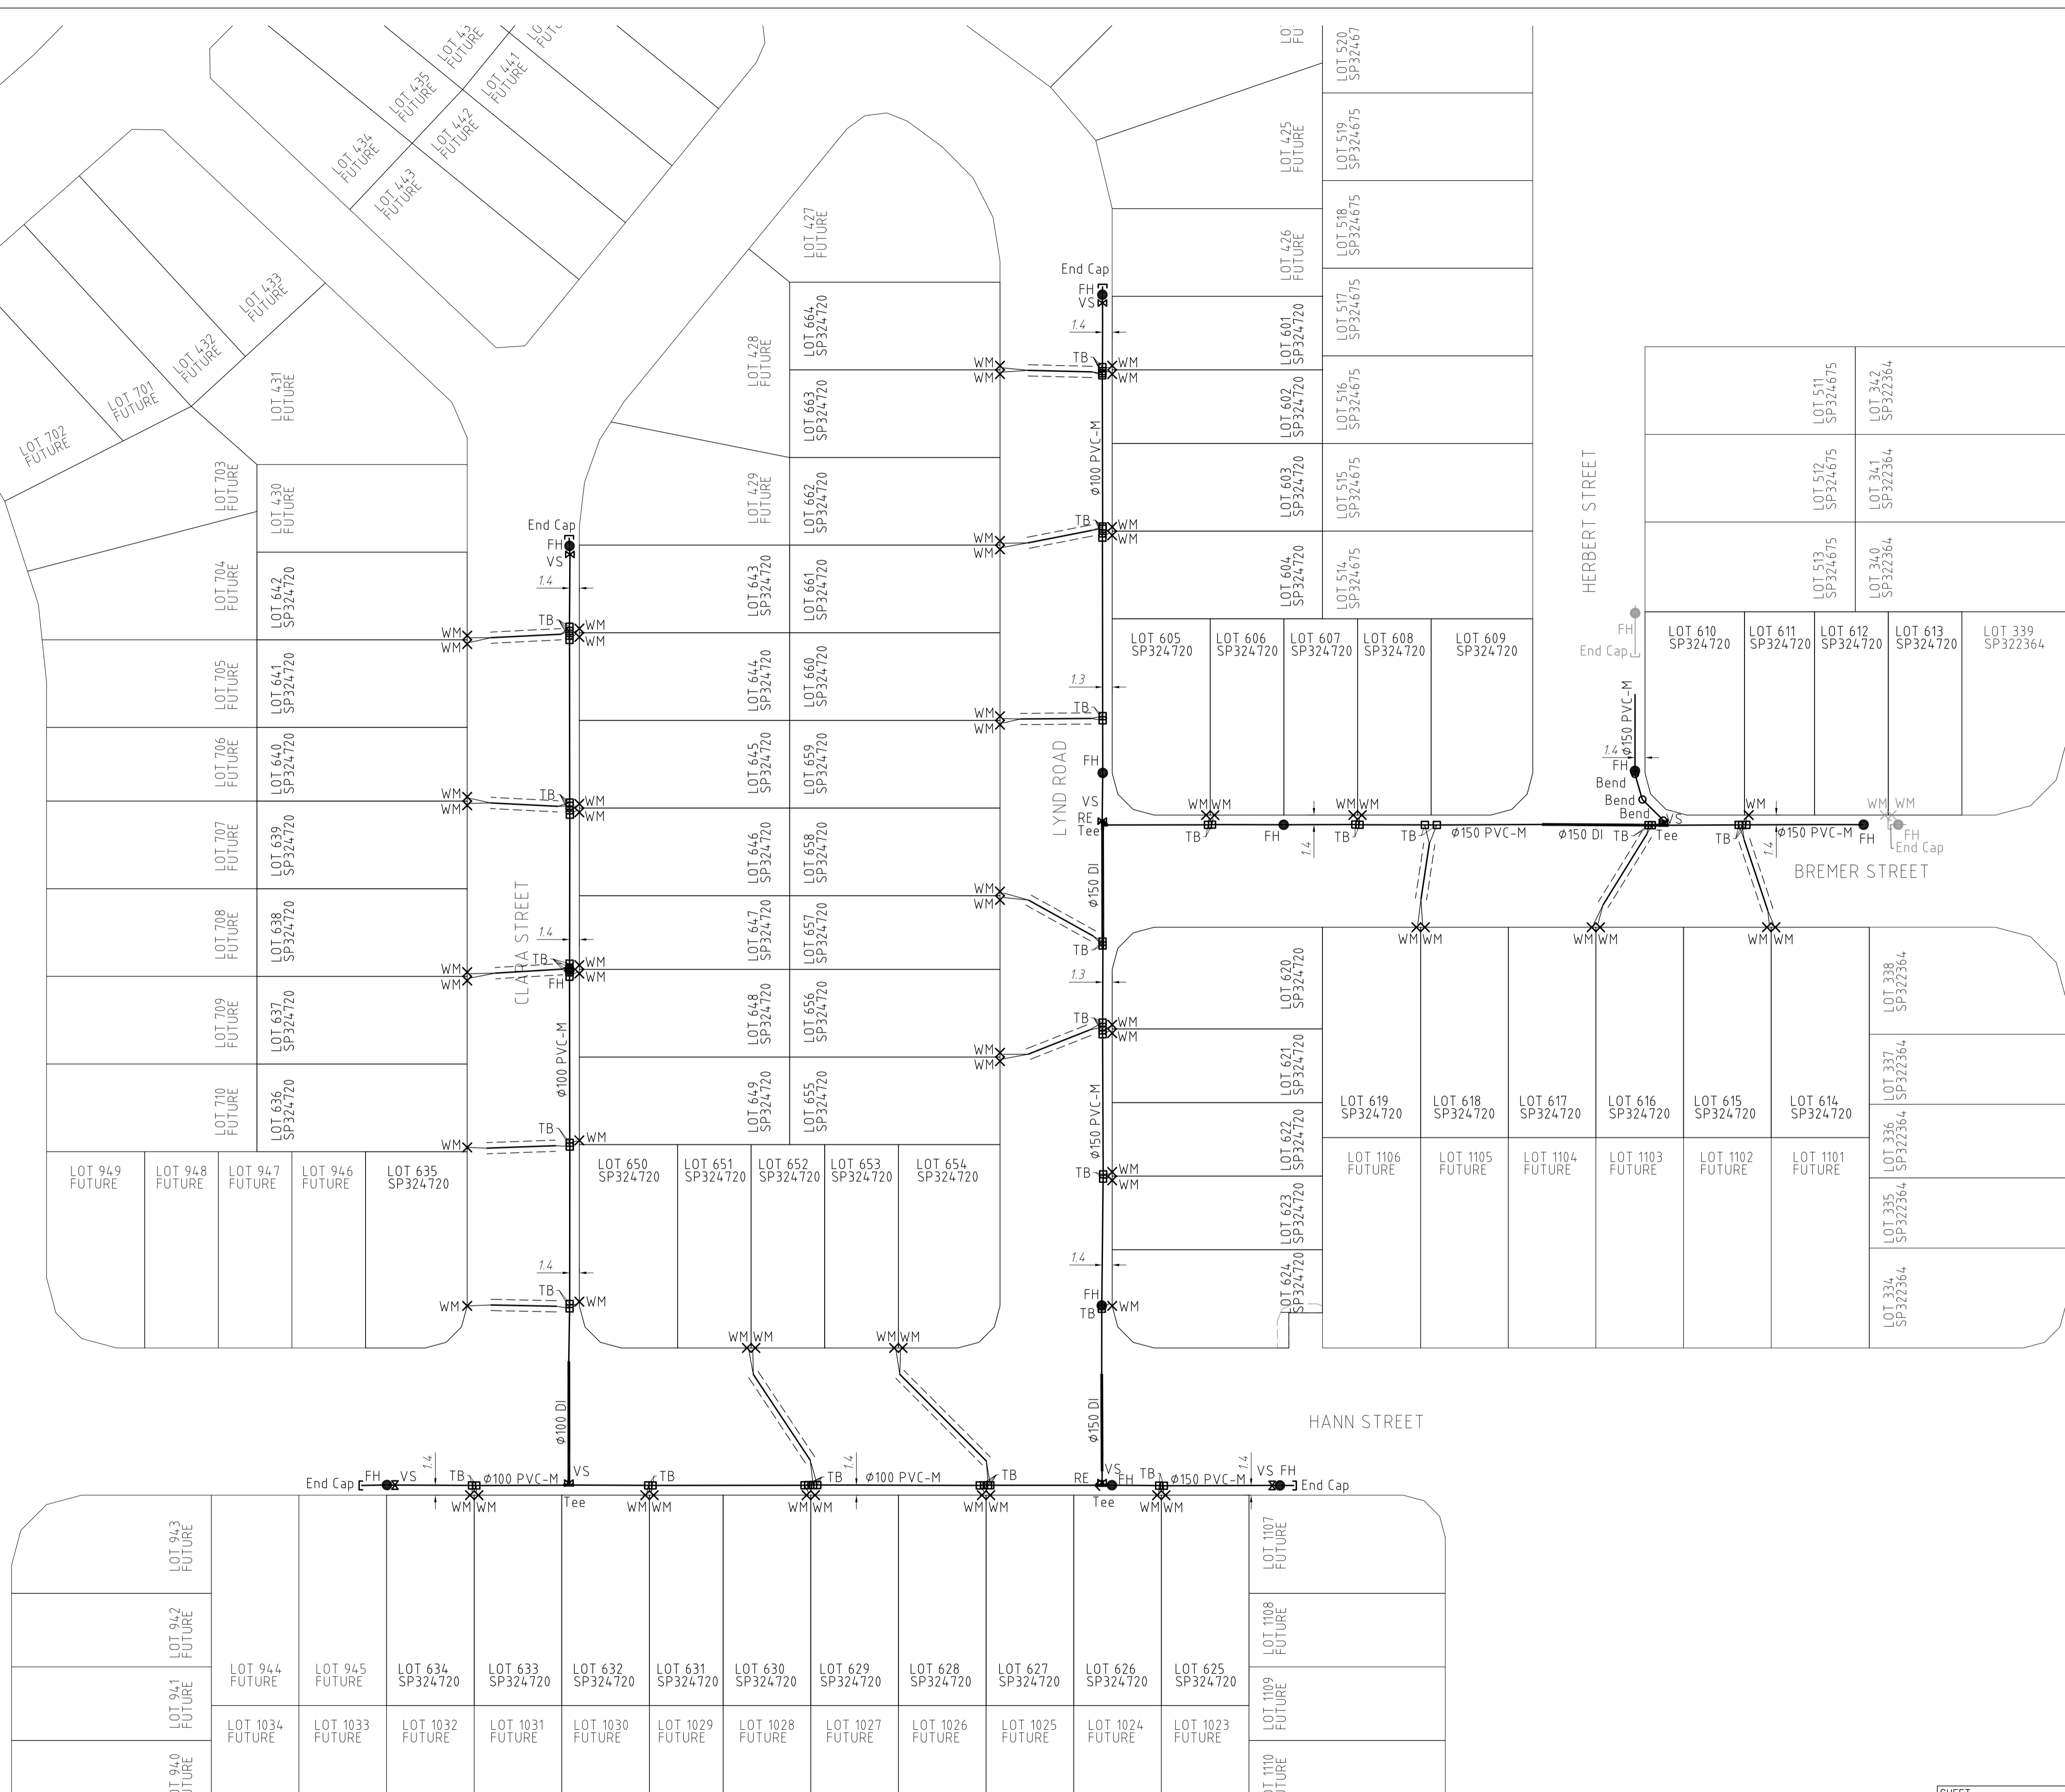

ISSUE	DATE	AUTHOR	COMMENTS
1	30/11/2021	BJB	INITIAL ISSUE
2	16/03/2022	BJB	SHOW EXISTING SERVICES
3	25/08/2022	BJB	DRAFTING AMENDMENT

ISSUE	DATE	AUTHOR	COMMENTS



Brisbane Office
 Level 1,
 28 Little Collins Street,
 Milton, QLD, 4064
 PO Box 1399
 1 (07) 3842 1000
 e info@landpartners.com.au
 www.landpartners.com.au

CLIENT
ORCHARD DEVELOPMENTS PTY LTD

PROJECT
**PEBBLE CREEK
 STAGE 6
 AS CONSTRUCTED WATER
 DEV2017/887**

ENGINEERING CONSULTANT
PEAK URBAN PTY LTD

LGA/SERVICE PROVIDER
ECONOMIC DEVELOPMENT QUEENSLAND

SCALE 1:500

SHEET 1 of 1		
DATUM	AHD	LEVEL ORIGIN
CONTOURS	N/A	FILE NO. BRSS7455-006-83-5
DRAWN	BJB	DATE 25/08/2022
CHECKED	RA	DATE 25/08/2022
APPROVED	RA	DATE 25/08/2022
PLAN NUMBER BRSS7455-006-85-3		