

NOTES

- ALL STORMWATER PIPES ARE RCP "3" U.N.O.
- MANHOLES 7-1, 6-1, 5-1, 4-1, 2-2 & 1-2 HAVE DESIGN SURFACE LEVELS

Works As Constructed

It is certified that the locations, Levels and dimensions of the infrastructure shown herein are a true representation of the constructed works and that the As-Constructed survey was performed to the prescribed accuracy standards.

Authorised Delegate.....*[Signature]*.....(Director)

Date.....25/08/2022.....

LandPartners Pty Ltd (ACN I18 146 008) Surveyor No. S4118

Works As Constructed

It is certified that works herein have been constructed to Local Government standards, relevant approved specifications and the operational works approval. The As-Constructed Drawings for these works constitutes a true and correct record of the works constructed and complies with the design intent.

Signature.....*[Signature]*.....RPEQ No.....

Date of Practical Completion.....

Engineering Consultant.....

LOT 949 FUTURE	LOT 948 FUTURE	LOT 947 FUTURE	LOT 946 FUTURE	LOT 635 SP324720	LOT 650 SP324720	LOT 651 SP324720	LOT 652 SP324720	LOT 653 SP324720	LOT 654 SP324720	LOT 620 SP324720	LOT 621 SP324720	LOT 622 SP324720	LOT 623 SP324720	LOT 624 SP324720	LOT 619 SP324720	LOT 618 SP324720	LOT 617 SP324720	LOT 616 SP324720	LOT 615 SP324720	LOT 614 SP324720	LOT 338 SP322364	LOT 337 SP322364	LOT 336 SP322364	LOT 335 SP322364	LOT 334 SP322364																																																																																																																																																																																						
LOT 702 FUTURE	LOT 701 FUTURE	LOT 703 FUTURE	LOT 704 FUTURE	LOT 705 FUTURE	LOT 706 FUTURE	LOT 707 FUTURE	LOT 708 FUTURE	LOT 709 FUTURE	LOT 710 FUTURE	LOT 643 FUTURE	LOT 642 FUTURE	LOT 641 FUTURE	LOT 640 FUTURE	LOT 639 FUTURE	LOT 638 FUTURE	LOT 637 FUTURE	LOT 636 FUTURE	LOT 635 FUTURE	LOT 634 FUTURE	LOT 633 FUTURE	LOT 632 FUTURE	LOT 631 FUTURE	LOT 630 FUTURE	LOT 629 FUTURE	LOT 628 FUTURE	LOT 627 FUTURE	LOT 626 FUTURE	LOT 625 FUTURE	LOT 1106 FUTURE	LOT 1105 FUTURE	LOT 1104 FUTURE	LOT 1103 FUTURE	LOT 1102 FUTURE	LOT 1101 FUTURE	LOT 511 SP324675	LOT 510 SP324675	LOT 509 SP322364

A1

ISSUE	DATE	AUTHOR	COMMENTS
1	14/01/2022	BJB	INITIAL ISSUE
2	28/01/2022	BJB	AMENDED ISSUE
3	25/08/2022	BJB	DRAFTING AMENDMENT

ISSUE	DATE	AUTHOR	COMMENTS



Brisbane Office
 Level 1,
 28 Little Collins Street,
 Milton, QLD, 4064
 PO Box 1399
 1 (07) 3842 1000
 e info@landpartners.com.au
 www.landpartners.com.au

CLIENT
ORCHARD DEVELOPMENTS PTY LTD


PROJECT
**PEBBLE CREEK
 STAGE 6
 AS CONSTRUCTED STORMWATER
 DEV2017/887**

ENGINEERING CONSULTANT
PEAK URBAN PTY LTD

LGA/SERVICE PROVIDER
ECONOMIC DEVELOPMENT QUEENSLAND

SCALE 1:500

SHEET		
1 of 2		
DATUM	AHD	LEVEL ORIGIN
CONTOURS	N/A	FILE NO. BRSS7455-006-88-3
DRAWN	BJB	DATE 25/08/2022
CHECKED	RA	DATE 25/08/2022
APPROVED	RA	DATE 25/08/2022
PLAN NUMBER	BRSS7455-006-89-3	

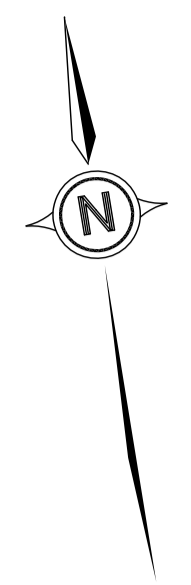

LOT 9002
FUTURE

BLOOMFIELD ESPLANADE

LOT 404 FUTURE	LOT 403 FUTURE	LOT 402 FUTURE	LOT 401 FUTURE	LOT 146 SP309239
LOT 537 SP324675	LOT 538 SP324675	LOT 539 SP324675	LOT 540 SP324675	LOT 145 SP309239


NOTES
 -ALL STORMWATER PIPES ARE RCP "3" U.N.O.
 -MANHOLES 7-1, 6-1, 5-1, 4-1, 2-2 & 1-2 HAVE DESIGN SURFACE LEVELS

Works As Constructed
 It is certified that the locations, Levels and dimensions of the infrastructure shown herein are a true representation of the constructed works and that the As-Constructed survey was performed to the prescribed accuracy standards.


Authorised Delegate.....*[Signature]*.....(Director)
 Date.....25/08/2022.....
 LandPartners Pty Ltd (ACN I18 146 008) Surveyor No. S4118

Works As Constructed
 It is certified that works herein have been constructed to Local Government standards, relevant approved specifications and the operational works approval. The As-Constructed Drawings for these works constitutes a true and correct record of the works constructed and complies with the design intent.

Signature.....RPEQ No.....
 Date of Practical Completion.....
 Engineering Consultant.....

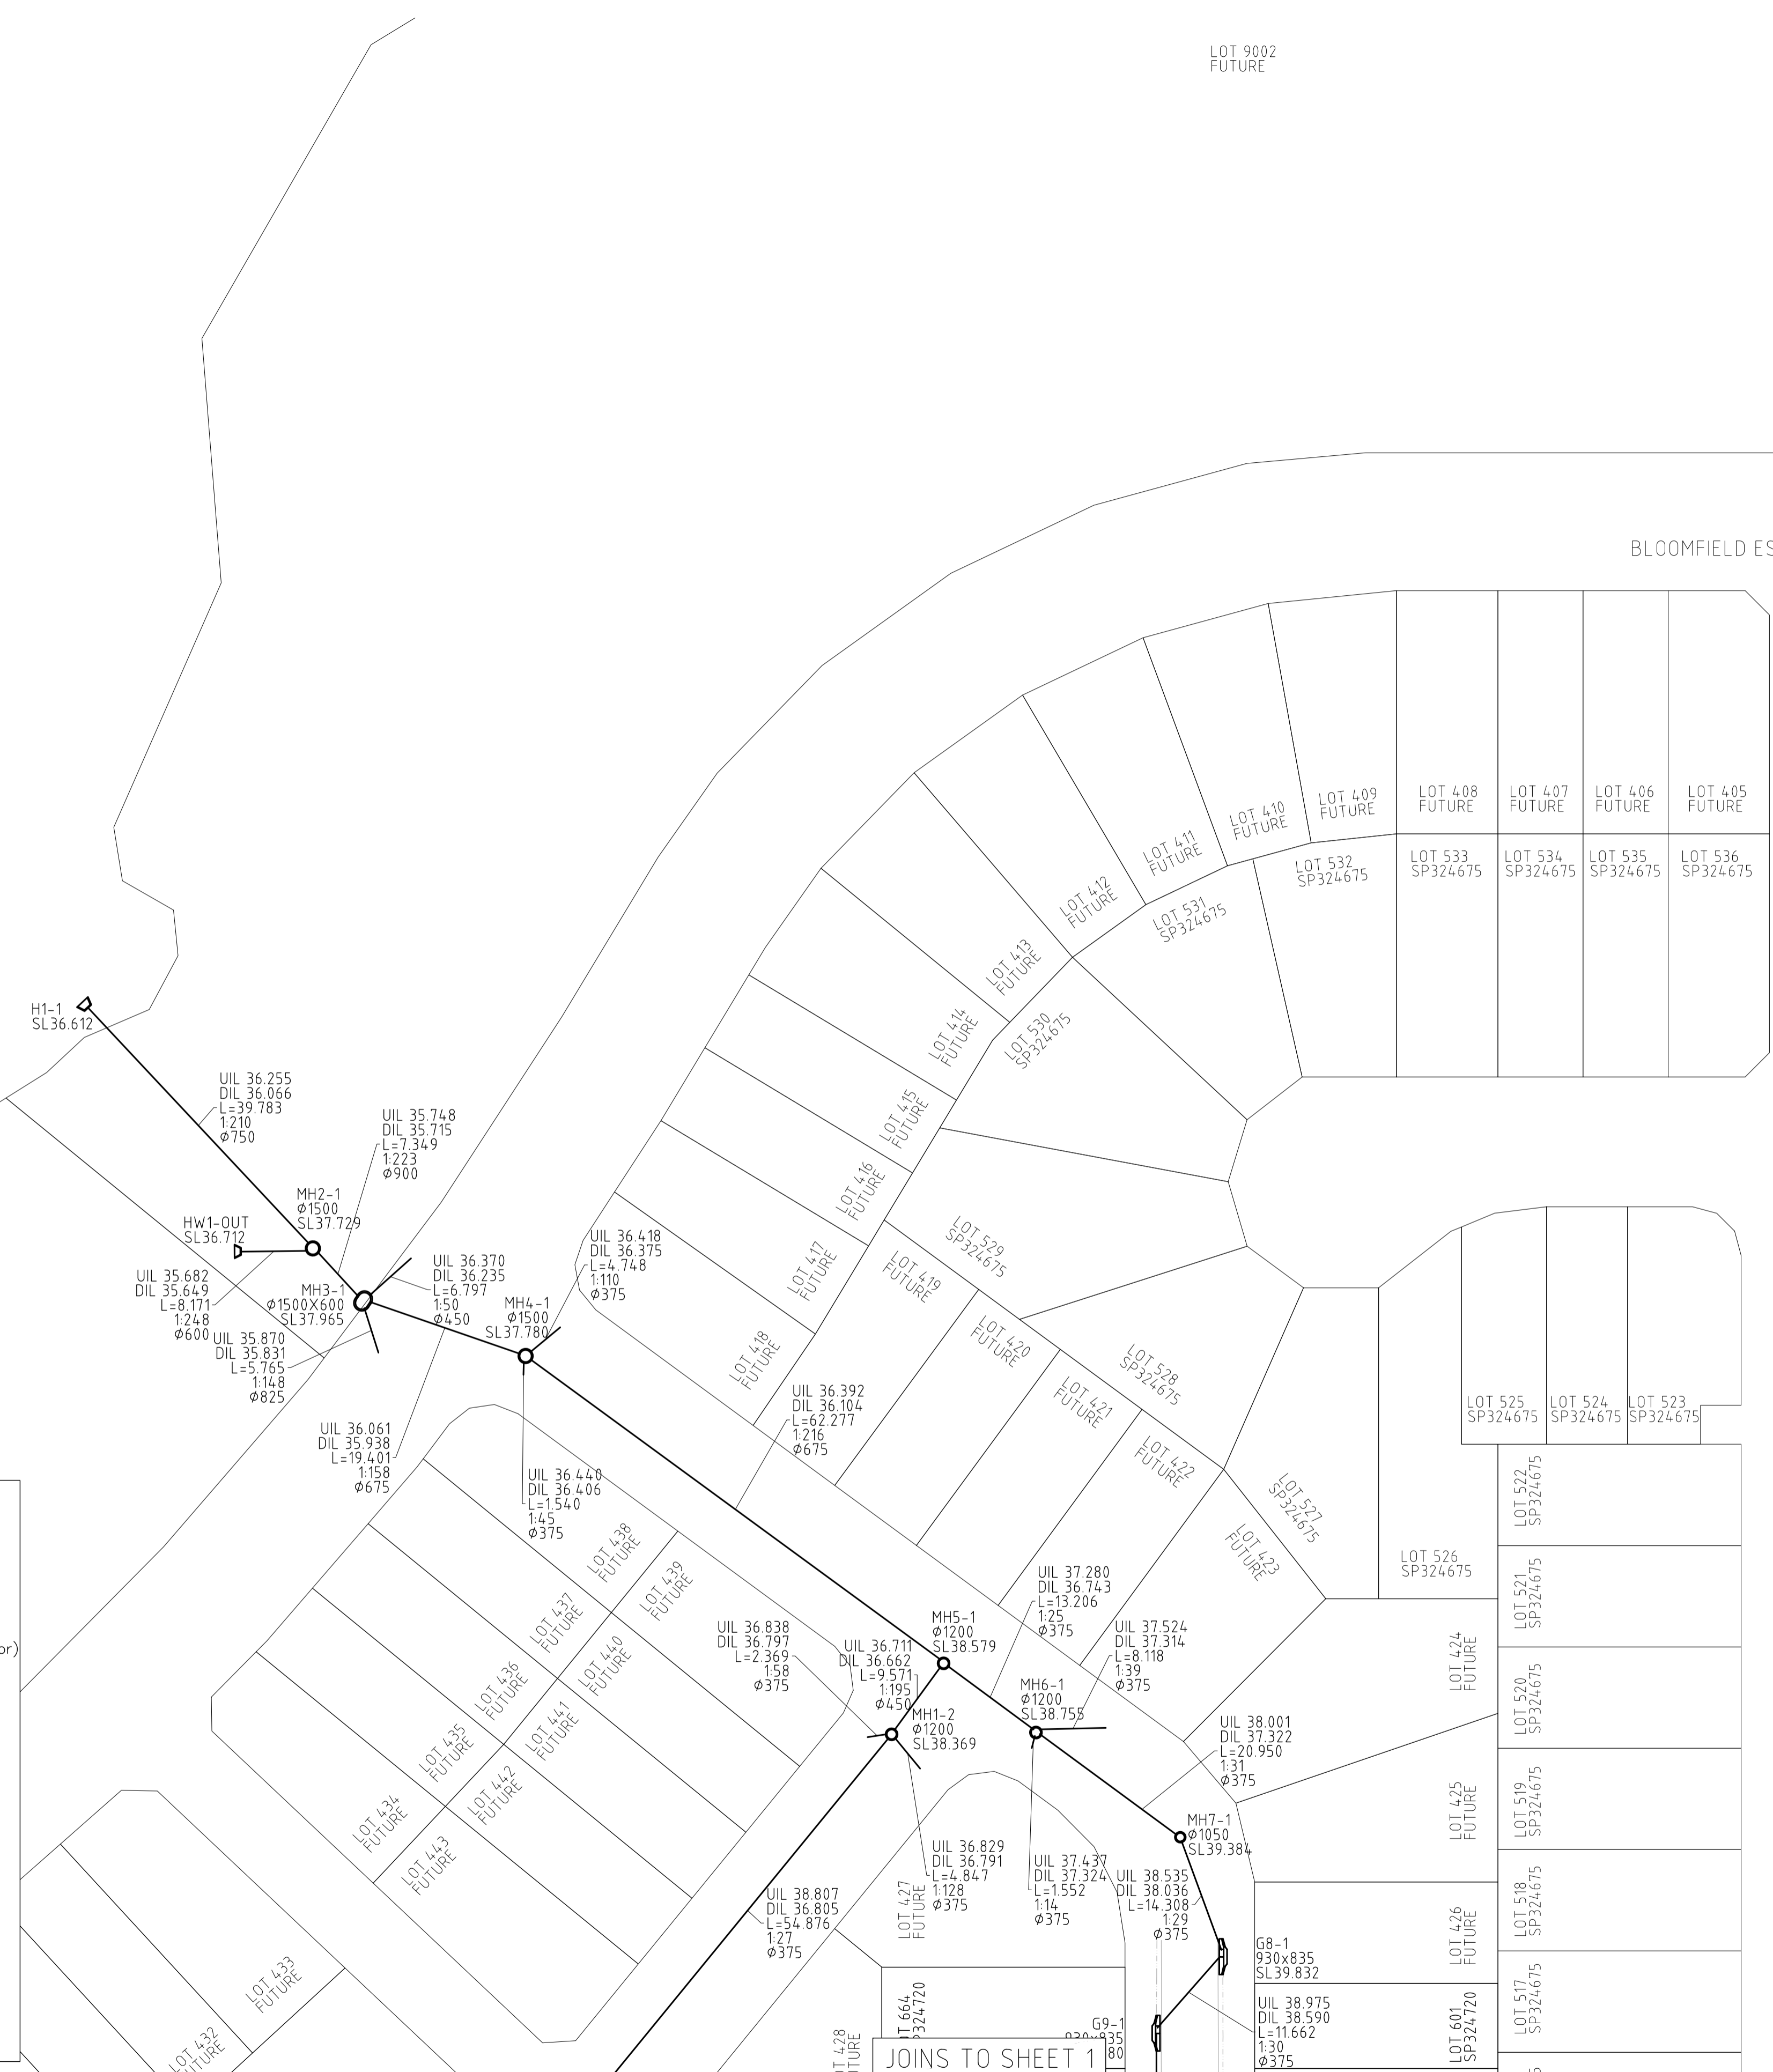

JOINS TO SHEET 1

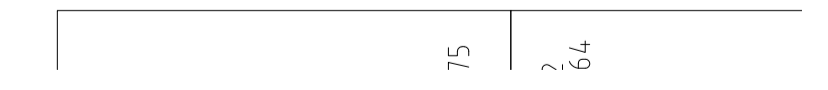

SHEET			2 of 2		
DATUM	AHD	LEVEL ORIGIN			
CONTOURS	N/A	FILE NO.	BRSS7455-006-88-3		
DRAWN	BJB	DATE	25/08/2022		
CHECKED	RA	DATE	25/08/2022		
APPROVED	RA	DATE	25/08/2022		
PLAN NUMBER		BRSS7455-006-89-3			

ISSUE	DATE	AUTHOR	COMMENTS	ISSUE	DATE	AUTHOR	COMMENTS
1	14/01/2022	BJB	INITIAL ISSUE				
2	28/01/2022	BJB	AMENDED ISSUE				
3	25/08/2022	BJB	DRAFTING AMENDMENT				



Brisbane Office
 Level 1,
 28 Little Collins Street,
 Milton, QLD, 4064
 PO Box 1399
 1 (07) 3842 1000
 e info@landpartners.com.au
 www.landpartners.com.au

CLIENT
ORCHARD DEVELOPMENTS PTY LTD

PROJECT
**PEBBLE CREEK
 STAGE 6
 AS CONSTRUCTED STORMWATER
 DEV2017/887**

ENGINEERING CONSULTANT
PEAK URBAN PTY LTD

LGA/SERVICE PROVIDER
ECONOMIC DEVELOPMENT QUEENSLAND

SCALE 1:500

A1