

**NOTES**

- ALL SEWER RETICULATION PIPES ARE #150 uPVC S8 U.N.O.
- ALL SEWER HOUSE CONNECTION PIPE ARE #100 uPVC S6 U.N.O.
- ALL SEWER HOUSE CONNECTIONS LABELED 'CALC' HAVE DEPTHS DERIVED FROM DESIGN SURFACE.
- MAINTENANCE HOLES MS5-41, MS3-41, MS7-41, MH8-41, MS9-41, MS10-41, MS3-47, MS1-48A, MH2-48, MH5-48, MS6-48, MS7-48, MH8-48, MS9-48, MS1-49, MH4-49, MH3-50, MS1-51 HAVE SURFACE LEVELS FROM DESIGN.

**Works As Constructed**

It is certified that the locations, Levels and dimensions of the infrastructure shown herein are a true representation of the constructed works and that the As-Constructed survey was performed to the prescribed accuracy standards.

Authorised Delegate.....*[Signature]*.....(Director)

Date.....09/12/2022.....

LandPartners Pty Ltd (ACN I18 146 008) Surveyor No. S4118

**Works As Constructed**

It is certified that the works herein have been constructed to Local Government standards, relevant approved specifications and the operational works approval. The As-Constructed Drawings for these works constitutes a true and correct record of the works constructed and complies with the design intent.

Signature.....*[Signature]*.....RPEQ No.....

Date of Practical Completion.....

Engineering Consultant.....

JOINS TO 'A'

ISSUE	DATE	AUTHOR	COMMENTS	ISSUE	DATE	AUTHOR	COMMENTS
A1	09/12/2022	BJB	PRELIMINARY ISSUE				



**Brisbane Office**  
 Level 1,  
 28/100 Collins Street,  
 Milton, QLD, 4064  
 PO Box 3399  
 1 (07) 3842 1001  
 e info@landpartners.com.au  
 www.landpartners.com.au


CLIENT  
**ORCHARD DEVELOPMENT QUEENSLAND**

PROJECT  
**PEBBLE CREEK  
 STAGE 7  
 AS CONSTRUCTED SEWER  
 DEV2017/887**

ENGINEERING CONSULTANT  
**PEAK URBAN PTY LTD**

LGA/SERVICE PROVIDER  
**ECONOMIC DEVELOPMENT QUEENSLAND**

SCALE 1:500

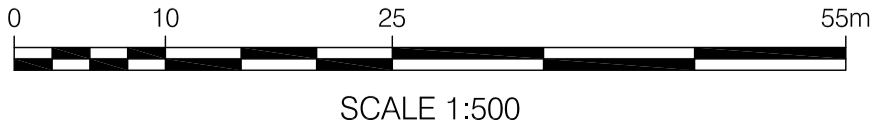

SHEET		
1 of 1		
DATUM	AHD	LEVEL ORIGIN
CONTOURS	N/A	FILE NO. BRSS7455-007-76-1
DRAWN	BJB	DATE 09/12/2022
CHECKED	RA	DATE 09/12/2022
APPROVED	RA	DATE 09/12/2022
PLAN NUMBER	BRSS7455-007-77-1	