
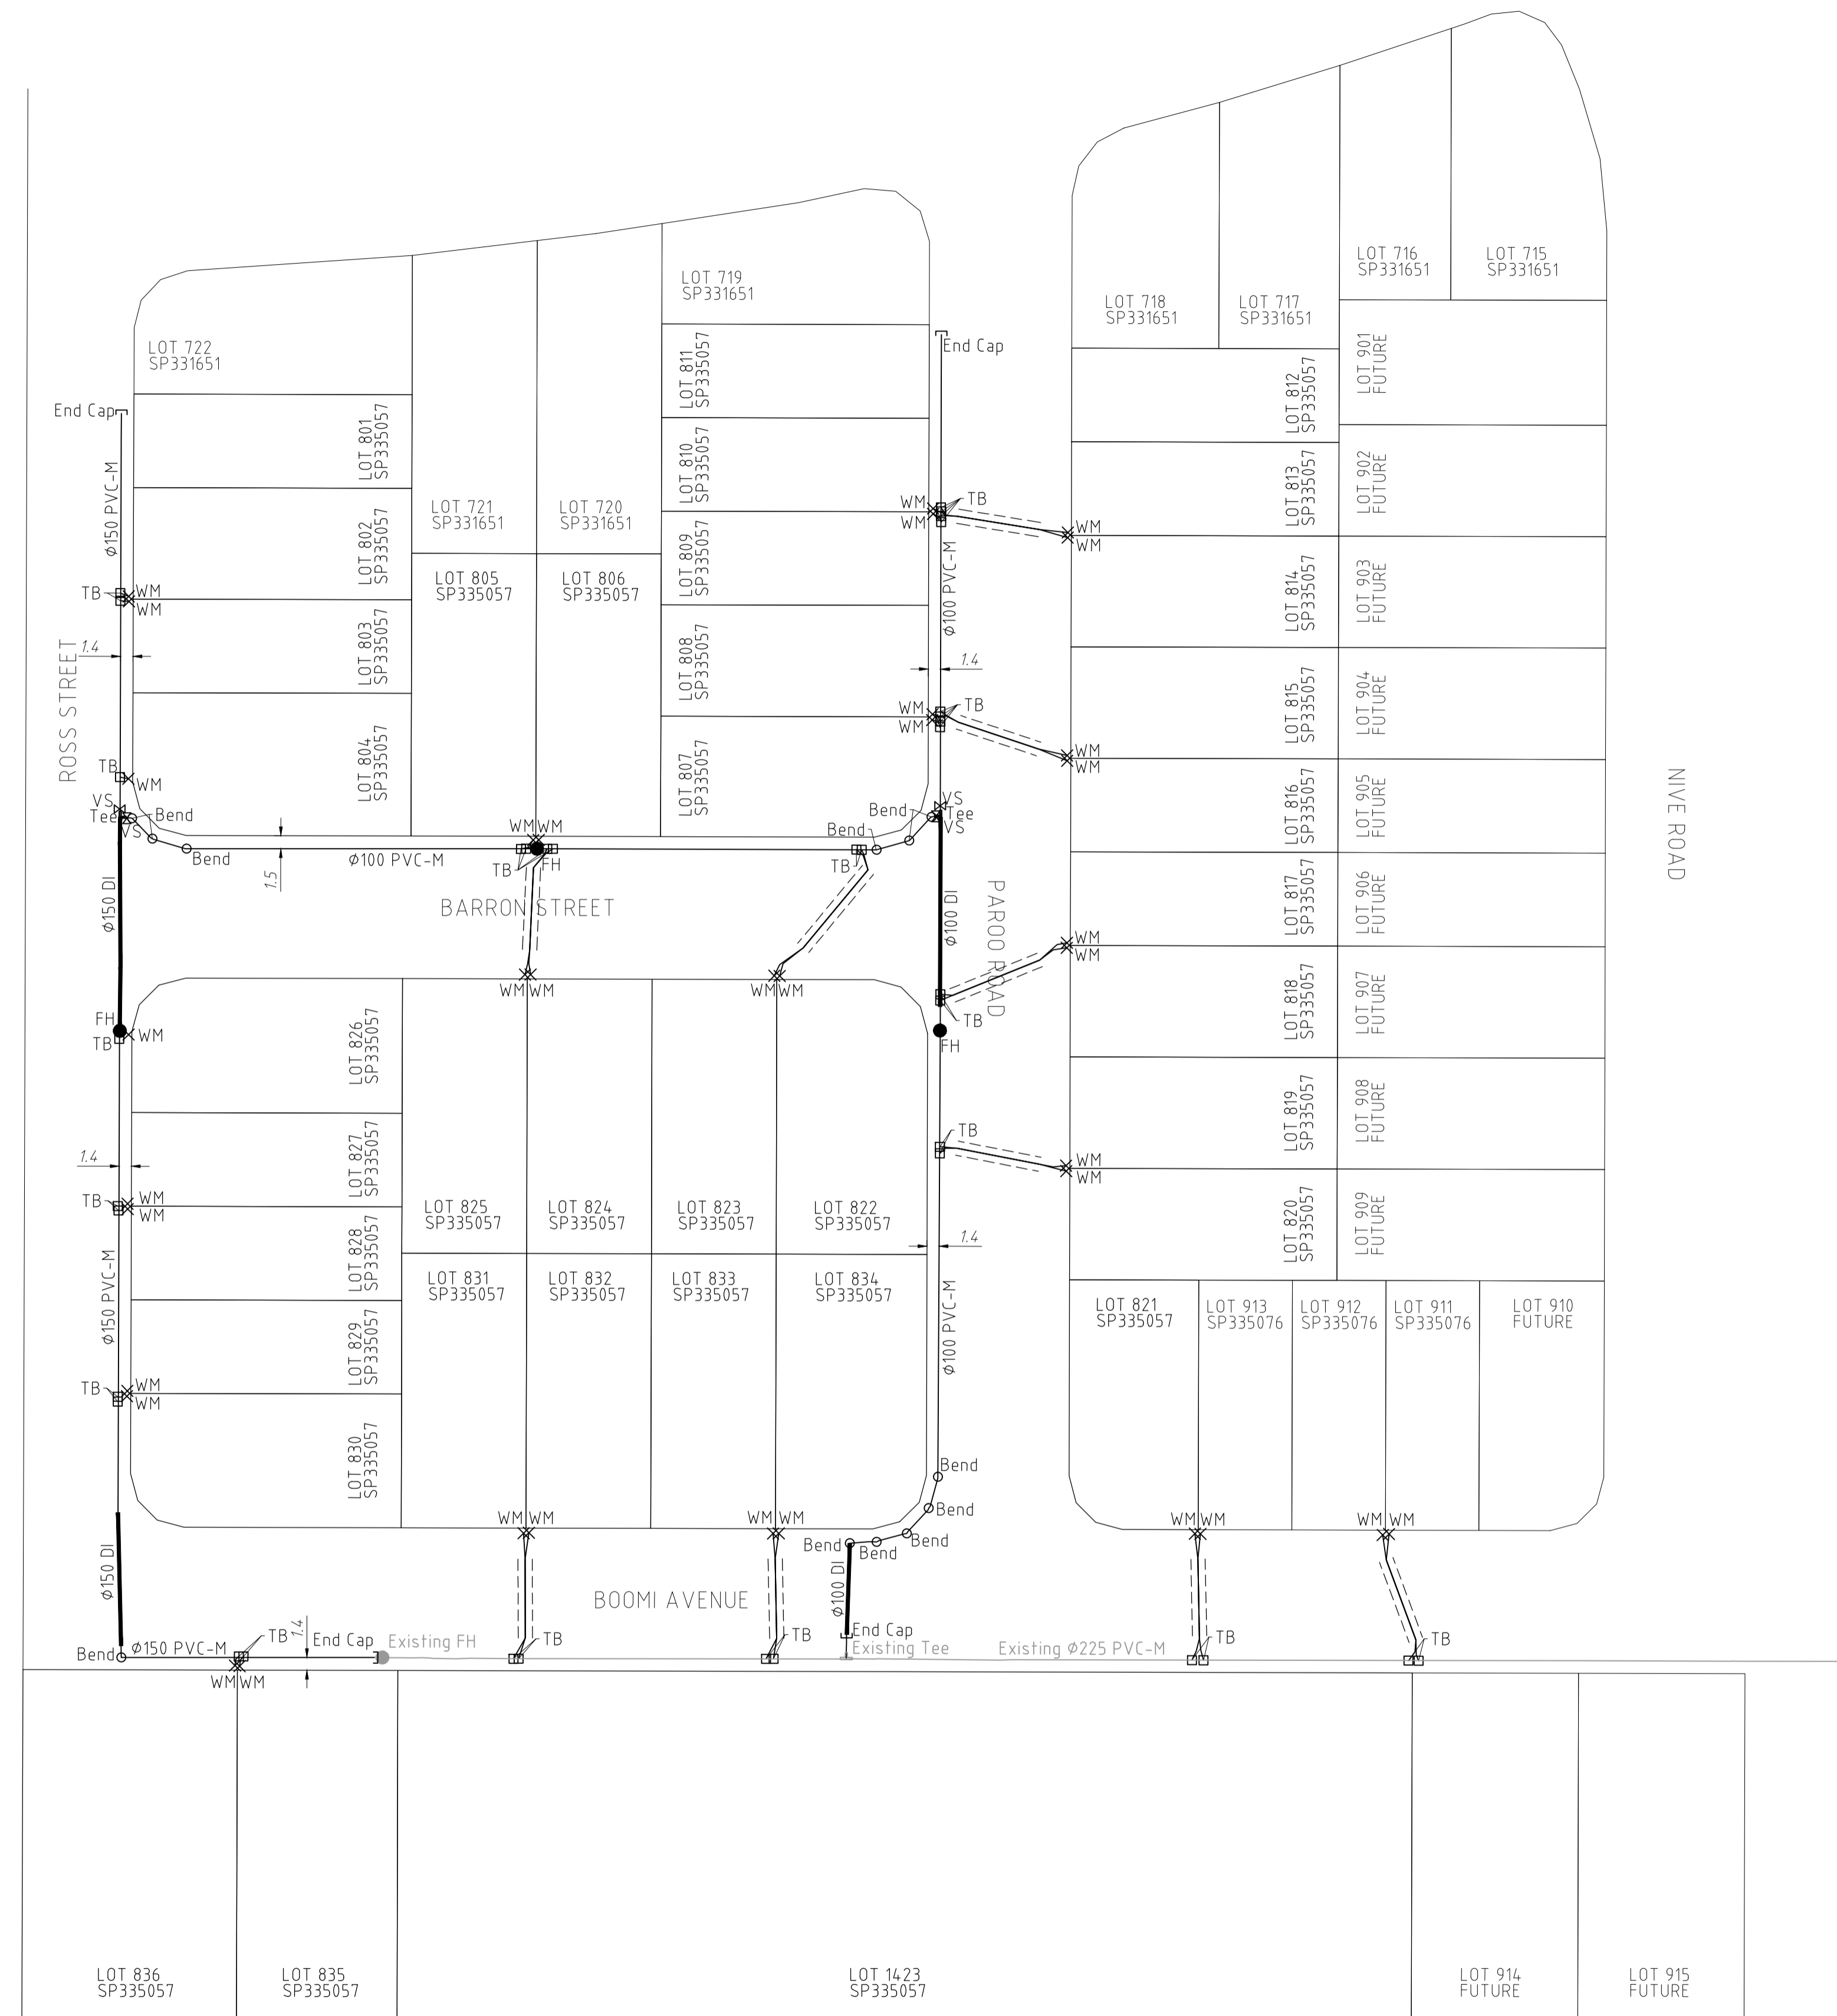


LEGEND

- (FH) FIRE HYDRANT
- ⊗ (VS) STOP VALVE
- (TB) TAPPING BAND
- × (WM) WATER METER (SEQ 20φ)
- └ END CAP
- ├ TEE
- BEND
- DICL WATER MAIN CROSSING
- ===== CONDUIT/CROSSING
- EXISTING WATER

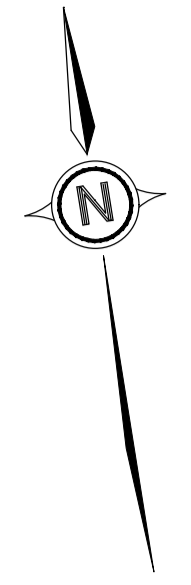

NOTES

- ALL WATER MAIN PIPES ARE PVC-M PN16 U.N.O.
- ALL WATER MAIN CROSSING PIPES ARE DICL PN35 U.N.O.
- ALL FIRE HYDRANTS ARE 100 SPRING U.N.O.
- ALL SERVICE CROSSING CONDUITS ARE 100 uPVC PN9 U.N.O.

Works As Constructed

It is certified that the locations, Levels and dimensions of the infrastructure shown herein are a true representation of the constructed works and that the As-Constructed survey was performed to the prescribed accuracy standards.

Authorised Delegate... *C. Walters*

Date.....29/06/2023.....

LandPartners Pty Ltd (ACN 118 146 008) Surveyor No. S4118

Works As Constructed

It is certified that works herein have been constructed to Local Government standards, relevant approved specifications and the operational works approval. The As-Constructed Drawings for these works constitutes a true and correct record of the works constructed and complies with the design intent.

Signature..... *[Signature]*RPEQ No. **20631**

Date of Practical Completion.....27/06/2023.....

Engineering Consultant..... **Troy Schultz - Colliers Engineering & Design Pty Ltd**

A1

ISSUE	DATE	AUTHOR	COMMENTS	ISSUE	DATE	AUTHOR	COMMENTS
1	29/06/2023	MJK	INITIAL ISSUE				

LANDPARTNERS
surveyors and planners

Brisbane Office
Level 11
18 Little Crebb Street
Milton Qld 4064
PO Box 1399
Milton Qld 4064

(07) 5842 1000
info@landpartners.com.au
www.landpartners.com.au

CLIENT
ORCHARD DEVELOPMENT QUEENSLAND PTY LTD

PROJECT
**PEBBLE CREEK
STAGE 8
AS CONSTRUCTED WATER**

ENGINEERING CONSULTANT
COLLIERS ENGINEERING & DESIGN PTY LTD

LGA/SERVICE PROVIDER
ECONOMIC DEVELOPMENT QUEENSLAND

0 10 25 55m
SCALE 1:500

SHEET		
1 of 1		
DATUM	AHD	LEVEL ORIGIN
CONTOURS	N/A	FILE NO. BRSS7455-008-48-1
DRAWN	MJK	DATE 29/06/2023
CHECKED	VO	DATE 29/06/2023
APPROVED	CGW	DATE 29/06/2023
PLAN NUMBER		BRSS7455-008-49-1