


**NOTES**  
 -ALL STORMWATER PIPES ARE RCP 3 U.N.O  
 -ALL PVC-U PIPES ARE CLASS 8 Ø150 U.N.O

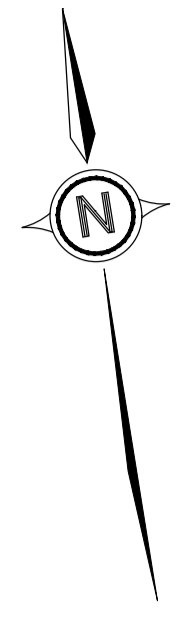

**Works As Constructed**  
 It is certified that the locations, Levels and dimensions of the infrastructure shown herein are a true representation of the constructed works and that the As-Constructed survey was performed to the prescribed accuracy standards.  
 Authorised Delegate: *C. Walters*  
 Date: 1/08/2023  
 LandPartners Pty Ltd (ACN 118 146 008) Surveyor No. S4118

**Works As Constructed**  
 It is certified that works herein have been constructed to Local Government standards, relevant approved specifications and the operational works approval. The As-Constructed Drawings for these works constitutes a true and correct record of the works constructed and complies with the design intent.  
 Signature: *Troy Schultz* RPEQ No. 20631  
 Date of Practical Completion: 22/06/2023  
 Engineering Consultant: **Troy Schultz**

A1

ISSUE	DATE	AUTHOR	COMMENTS	ISSUE	DATE	AUTHOR	COMMENTS
1	1/08/2023	MJK	INITIAL ISSUE				



CLIENT: ORCHARD DEVELOPMENT QUEENSLAND PTY LTD  
 PROJECT: PEBBLE CREEK STAGE 9 AS CONSTRUCTED STORMWATER DEV2017/887

ENGINEERING CONSULTANT: COLLIER'S ENGINEERING & DESIGN PTY LTD  
 LGA/SERVICE PROVIDER: ECONOMIC DEVELOPMENT QUEENSLAND  
 SCALE 1:500

SHEET 1 of 1		
DATUM	AHD	LEVEL ORIGIN
CONTOURS	N/A	FILE NO. BRSS7455-009-59-1
DRAWN	MJK	DATE 1/08/2023
CHECKED	VO	DATE 1/08/2023
APPROVED	CGW	DATE 1/08/2023
PLAN NUMBER		BRSS7455-009-60-1