

Consulting Engineer's Certification:

I, ..... hereby certify that the As Constructed information shown on the plan is a true and correct record of the sizes, types, materials, classes etc., and it corresponds with the relevant approved Engineering Drawings.

Signed..... RPEQ No..... Dated.....

---

REGISTERED CADASTRAL SURVEYOR (QLD) CERTIFICATION:

LandPartners Pty Ltd, hereby certify that the horizontal and vertical locations, and dimensions shown on this plan are a true and correct record of the As Constructed information.

Signed, *R. G. Andrew*..... Date **21/08/2024**.....  
(Authorised Delegate)

LandPartners Pty Ltd, Registered Cadastral Surveyor SBQ ID 4118



CLIENT  
**ORCHARD (PEBBLE CREEK) DEVELOPMENTS PTY LTD**

PROJECT  
**AS CONSTRUCTED TOPOGRAPHY**  
PEBBLE CREEK STAGE 13  
DEV 2017 / 887

NOTES

**LEGEND**

	BOTTOM OF WALL
	TOP OF WALL
	LIP OF KERB
	BACK OF KERB
	EDGE OF CONCRETE
	EDGE OF ROCK
	CONTOURS
	CHANGE OF GRADE
	BOTTOM OF BANK
	TOP OF BANK
	CROWN OF ROAD
	FENCE

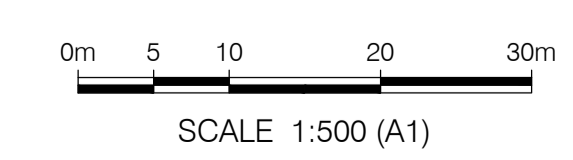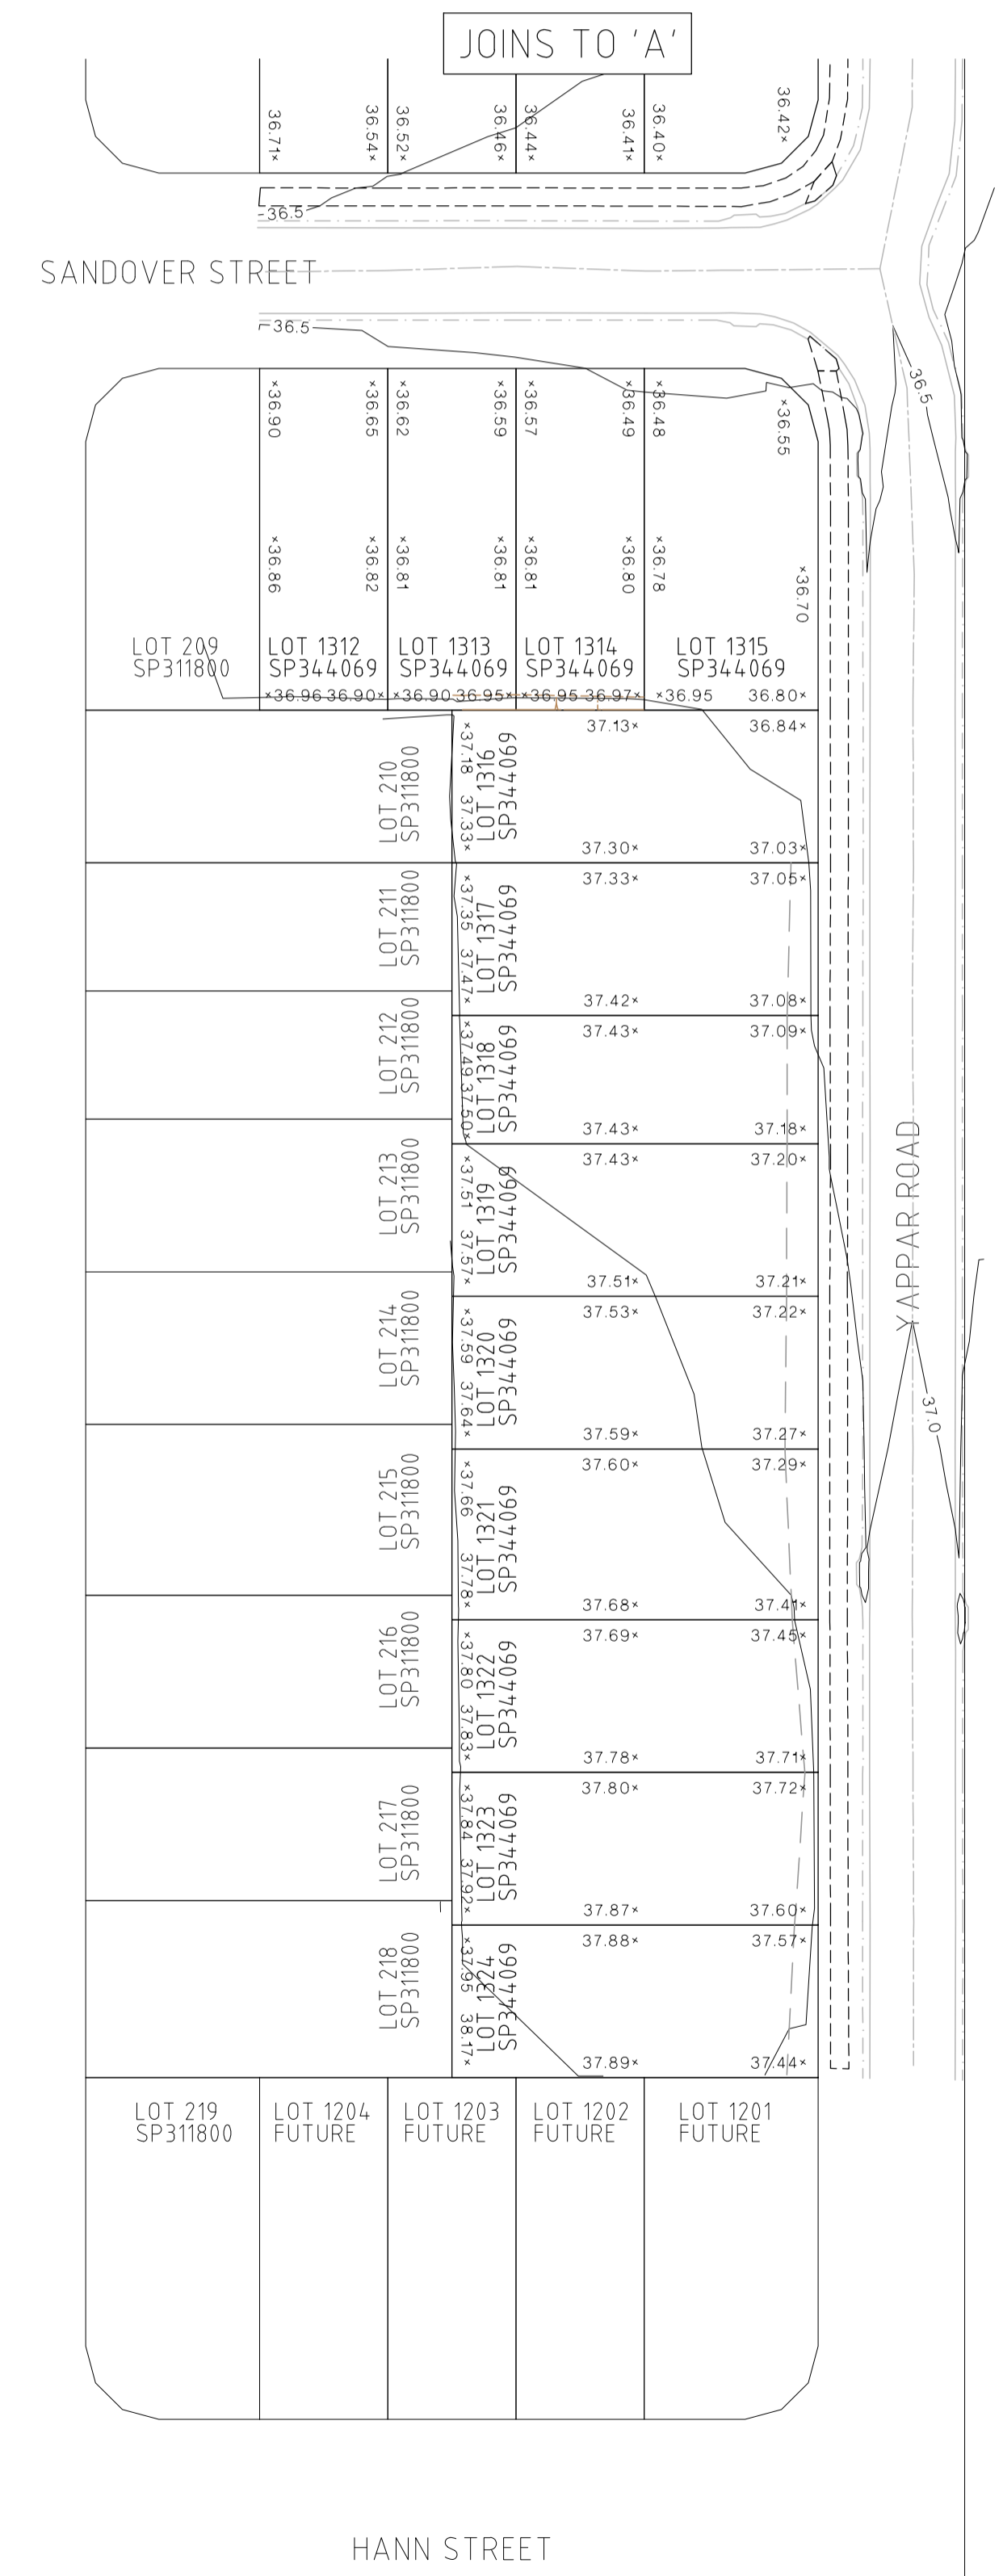

1	21/08/2024	BJB	RA	RA	21/08/2024
REV	DATE	DRAWN	CHECKED	APPROVED	APPROVAL DATE

Brisbane Office  
Level 1  
18 Little Cribb Street  
Milton QLD 4064

PO Box 1399  
Milton  
QLD 4064

p: (07) 3842 1000  
f: (07) 3842 1001  
e: info@landpartners.com.au  
w: www.landpartners.com.au

LEVEL DATUM AHD	LOCAL AUTHORITY LOGAN C.C.
LEVEL ORIGIN -	CONTOUR INTERVAL 0.5 Metre
MERIDIAN MGA84	CO-ORD SYSTEM MGA ZONE 56

UDN  
**BRSS7455-013-42-1**

SHEET 1 OF 1

LANDPARTNERS 2024