

Consulting Engineer's Certification:

I, hereby certify that the As Constructed information shown on the plan is a true and correct record of the sizes, types, materials, classes etc., and it corresponds with the relevant approved Engineering Drawings.

Signed..... RPEQ No..... Dated.....

REGISTERED CADASTRAL SURVEYOR (QLD) CERTIFICATION:

LandPartners Pty Ltd, hereby certify that the horizontal and vertical locations, and dimensions shown on this plan are a true and correct record of the As Constructed information.

R. G. Anderson 4118 24/02/2025
 Authorised Delegate Rego No. Date
 LandPartners Pty Ltd
 Registered Qld Surveyor Corporation

CLIENT
ORCHARD (PEBBLE CREEK) DEVELOPMENTS PTY LTD

PROJECT
AS CONSTRUCTED TOPOGRAPHY
PEBBLE CREEK STAGE 11
DEV 2017 / 887



LEGEND

- LIP OF KERB
- BACK OF KERB
- EDGE OF CONCRETE
- CONTOURS
- CHANGE OF GRADE
- BOTTOM OF BANK
- TOP OF BANK
- CROWN OF ROAD

PRELIMINARY

ENGINEERING FIRM:
COLLIERS ENGINEERING & DESIGN PTY LTD

REV	DATE	DRAWN	CHECKED	APPROVED	SURVEY DATE
2	24/02/2025	MJK	RA	RA	13/02/2025
1	20/02/2025	MJK	RA	RA	13/02/2025

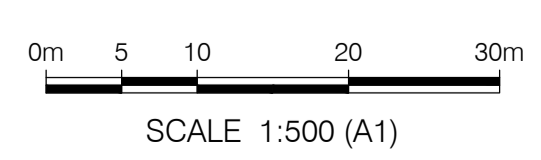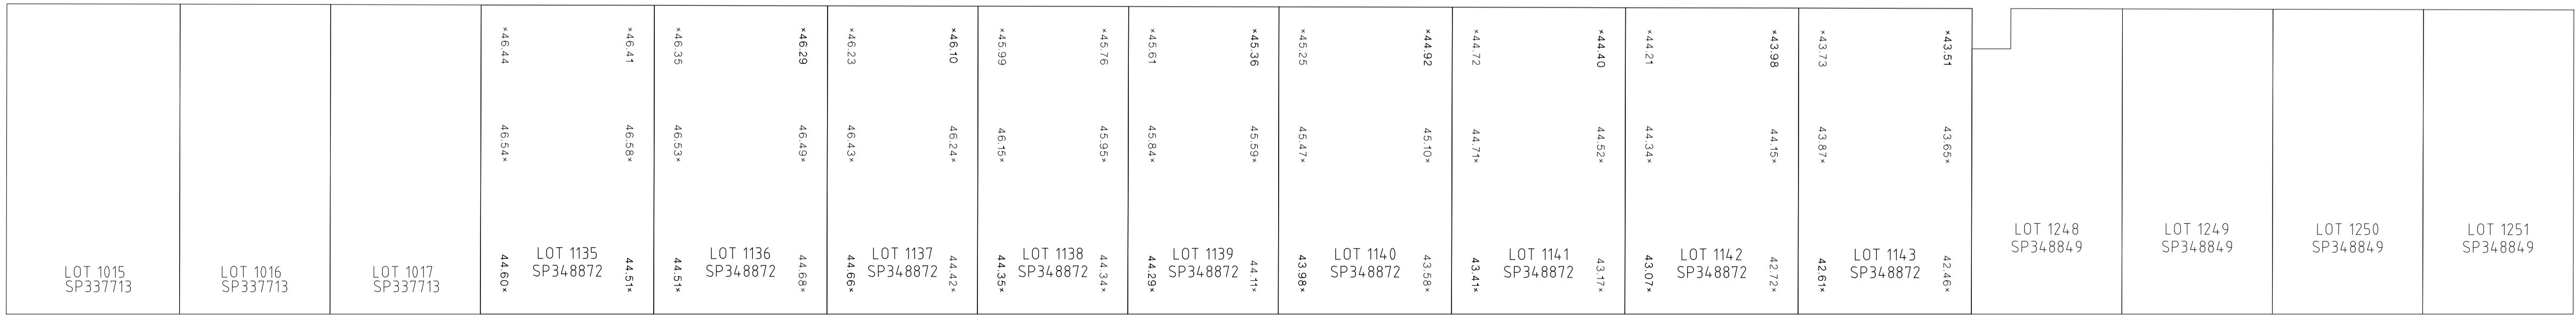

LANDPARTNERS
 surveyors and planners

bsi ISO 9001 Certified Quality Management System CERTIFIED
 ISO 45001 Occupational Health and Safety Management System CERTIFIED
CERTIFIED LOCATOR

Brisbane Office Level 1 18 Little Cribb Street Milton QLD 4064
 PO Box 1399 Milton QLD 4064
 p: (07) 3842 1000 f: (07) 3842 1001
 info@landpartners.com.au www.landpartners.com.au

LEVEL DATUM AHD LOCAL AUTHORITY LOGAN C.C.
 LEVEL ORIGIN - CONTOUR INTERVAL 0.5 Metre
 MERIDIAN MGA2020 CO-ORD SYSTEM MGA ZONE 56

UDN SHEET 1 OF 1
BRSS7455-011-82-2

©LANDPARTNERS 2025