

Consulting Engineer's Certification:

I, ..... hereby certify that the As Constructed information shown on the plan is a true and correct record of the sizes, types, materials, classes etc., and it corresponds with the relevant approved Engineering Drawings.

Signed..... RPEQ No..... Dated.....

REGISTERED CADASTRAL SURVEYOR (QLD) CERTIFICATION:

LandPartners Pty Ltd, hereby certify that the horizontal and vertical locations, and dimensions shown on this plan are a true and correct record of the As Constructed information.


*R. G. Anderson* 4118 24/02/2025  
 Authorised Delegate Rego No. Date  
 LandPartners Pty Ltd  
 Registered Qld Surveyor Corporation

CLIENT  
**ORCHARD (PEBBLE CREEK) DEVELOPMENTS PTY LTD**


PROJECT  
**AS CONSTRUCTED TOPOGRAPHY**  
**PEBBLE CREEK STAGE 11**  
**DEV 2017 / 887**

LEGEND

- LIP OF KERB
- BACK OF KERB
- EDGE OF CONCRETE
- CONTOURS
- CHANGE OF GRADE
- BOTTOM OF BANK
- TOP OF BANK
- CROWN OF ROAD

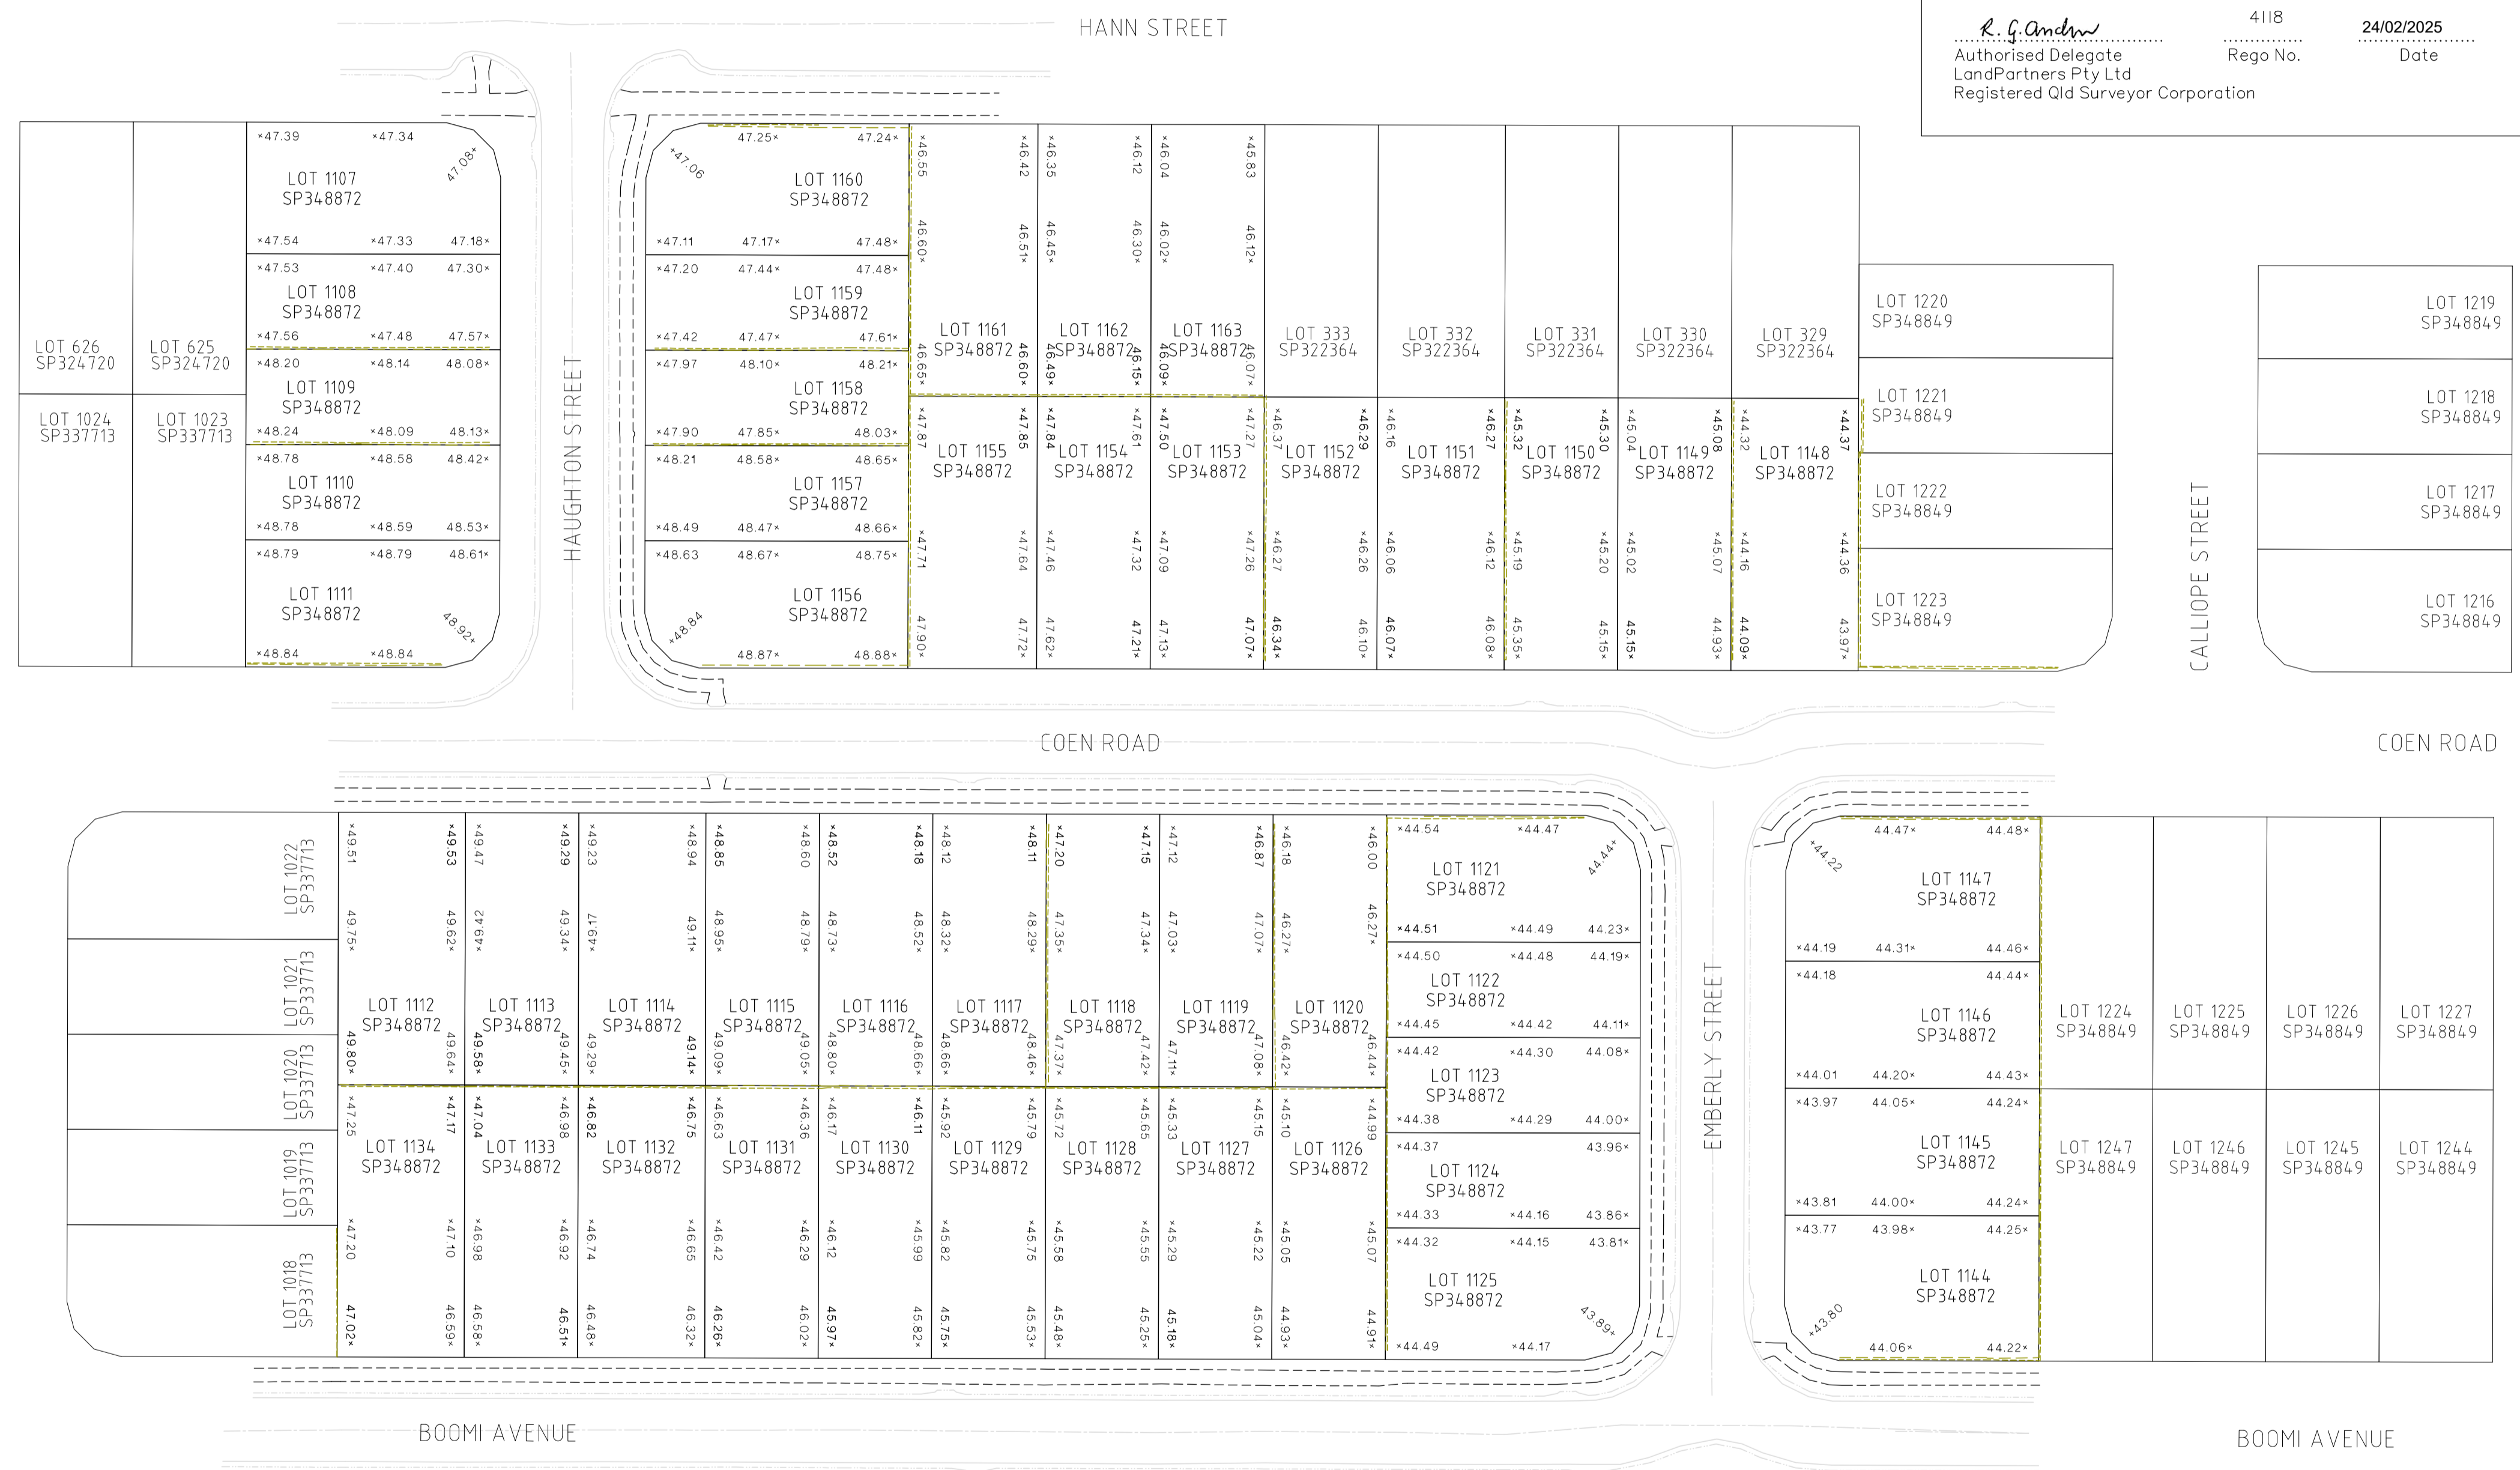

LOT 1015 SP337713	LOT 1016 SP337713	LOT 1017 SP337713	LOT 1105 SP348872	LOT 1106 SP348872	LOT 1107 SP348872	LOT 1108 SP348872	LOT 1109 SP348872	LOT 1110 SP348872	LOT 1111 SP348872	LOT 1112 SP348872	LOT 1113 SP348872	LOT 1114 SP348872	LOT 1115 SP348872	LOT 1116 SP348872	LOT 1117 SP348872	LOT 1118 SP348872	LOT 1119 SP348872	LOT 1120 SP348872	LOT 1121 SP348872	LOT 1122 SP348872	LOT 1123 SP348872	LOT 1124 SP348872	LOT 1125 SP348872	LOT 1147 SP348872	LOT 1148 SP348872	LOT 1149 SP348872	LOT 1150 SP348872	LOT 1151 SP348872	LOT 1152 SP348872	LOT 1153 SP348872	LOT 1154 SP348872	LOT 1155 SP348872	LOT 1156 SP348872	LOT 1166 SP348872	LOT 1167 SP348872	LOT 1168 SP348872
----------------------	----------------------	
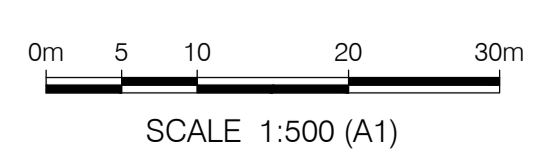

ENGINEERING FIRM:  
**COLLIERS ENGINEERING & DESIGN PTY LTD**

REV	DATE	DRAWN	CHECKED	APPROVED	SURVEY DATE
2	24/02/2025	MJK	RA	RA	13/02/2025
1	20/02/2025	MJK	RA	RA	13/02/2025

**LANDPARTNERS**  
 surveyors and planners

bsi ISO 9001 Certified Management System CERTIFIED  
 ISO 45001 Occupational Health and Safety Management System CERTIFIED  
**CERTIFIED LOCATOR**

Brisbane Office Level 1 18 Little Cribb Street Milton QLD 4064  
 PO Box 1399 Milton QLD 4064  
 p: (07) 3842 1000 f: (07) 3842 1001  
 info@landpartners.com.au www.landpartners.com.au

LEVEL DATUM AHD LOCAL AUTHORITY LOGAN C.C.  
 LEVEL ORIGIN - CONTOUR INTERVAL 0.5 Metre  
 MERIDIAN MGA2020 CO-ORD SYSTEM MGA ZONE 56  
 UDN SHEET 1 OF 1

**BRSS7455-011-82-2**

©LANDPARTNERS 2025