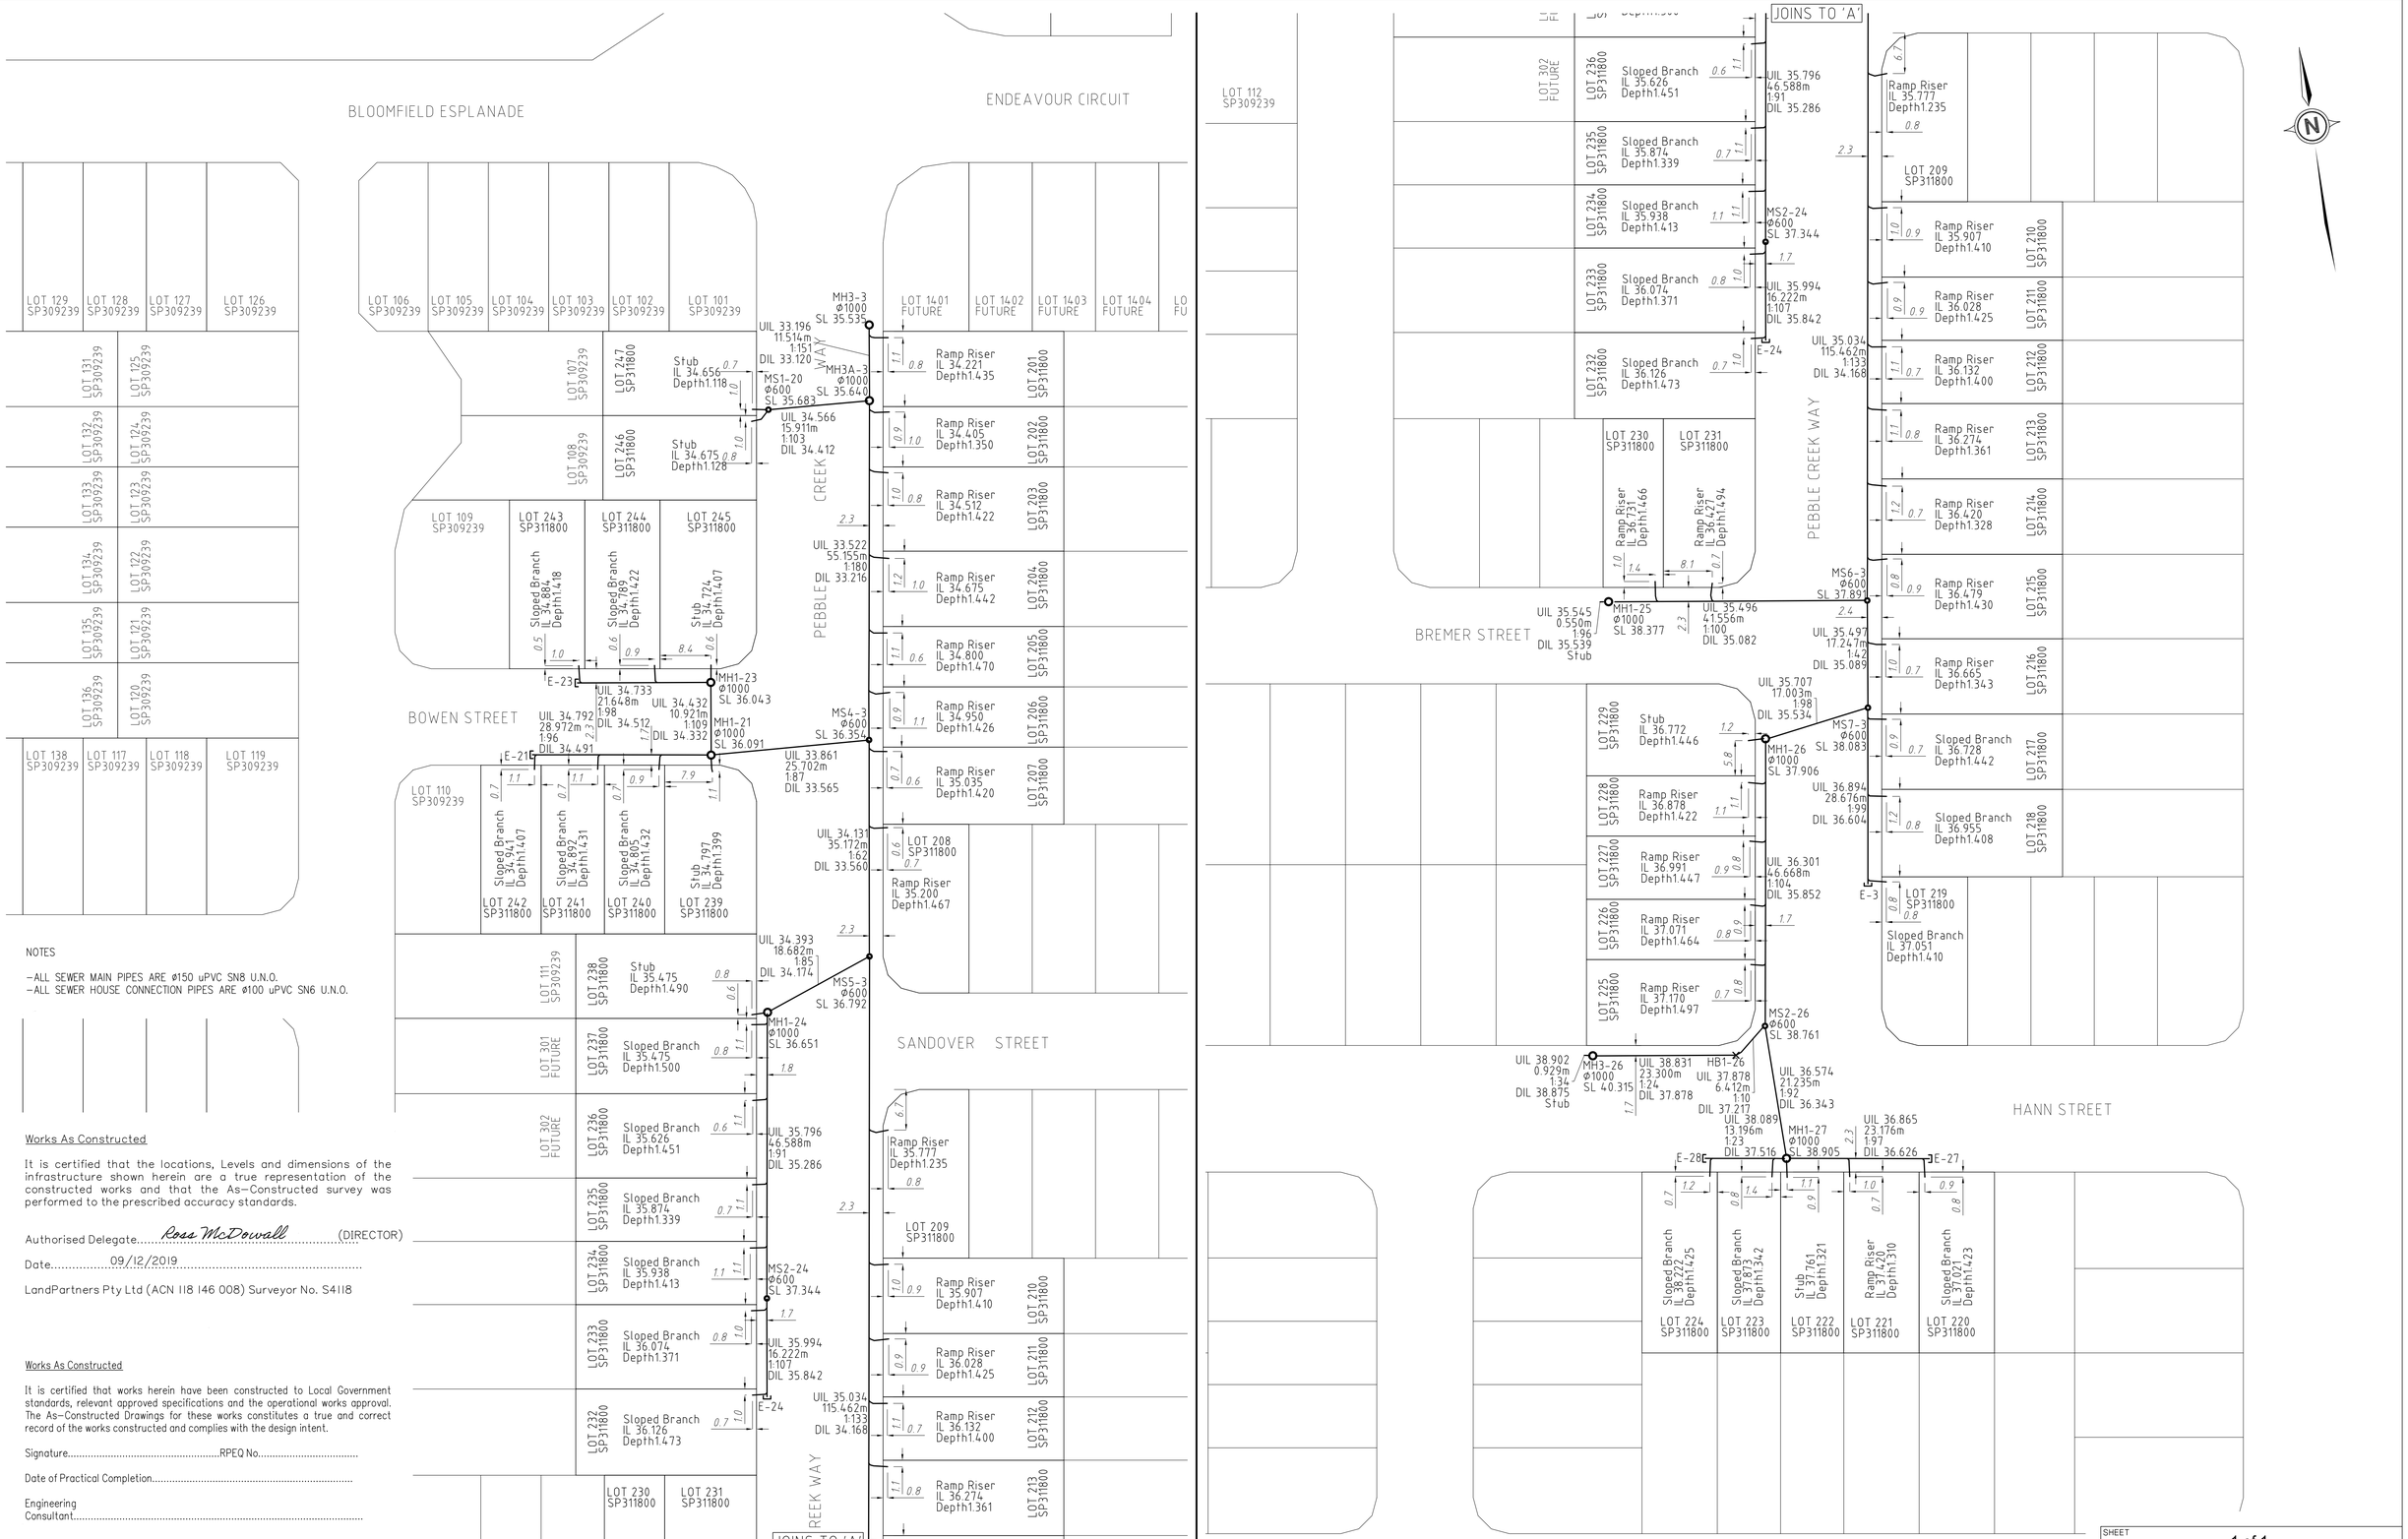

NOTES

- ALL SEWER MAIN PIPES ARE Ø150 uPVC SN8 U.N.O.
- ALL SEWER HOUSE CONNECTION PIPES ARE Ø100 uPVC SN6 U.N.O.

Works As Constructed

It is certified that the locations, Levels and dimensions of the infrastructure shown herein are a true representation of the constructed works and that the As-Constructed survey was performed to the prescribed accuracy standards.

Authorised Delegate..... Ross McDowall (DIRECTOR)

Date..... 09/12/2019

LandPartners Pty Ltd (ACN 118 146 008) Surveyor No. S4118

Works As Constructed

It is certified that works herein have been constructed to Local Government standards, relevant approved specifications and the operational works approval. The As-Constructed Drawings for these works constitutes a true and correct record of the works constructed and complies with the design intent.

Signature.....RPEQ No.....

Date of Practical Completion.....

Engineering Consultant.....

ISSUE	DATE	AUTHOR	COMMENTS	ISSUE	DATE	AUTHOR	COMMENTS
1	09/12/2019	BJB	INITIAL ISSUE				

A1

LANDPARTNERS built environment consultants

Brisbane Office
Level 1,
18 Little Cribb Street,
Milton, QLD, 4064
PO Box 1399
t (07) 3842 1000
f (07) 3842 1001
e info@landpartners.com.au
w www.landpartners.com.au

ISO 9001:2008 FS 510063

CLIENT	ORCHARD DEVELOPMENTS PTY LTD
PROJECT	PEBBLE CREEK STAGE 2 AS CONSTRUCTED SEWER DEV2017/887/23
ENGINEERING CONSULTANT	PEAK URBAN PTY LTD
LGA/SERVICE PROVIDER	ECONOMIC DEVELOPMENT QUEENSLAND

0 10 25 55m

SCALE 1:500

SHEET	1 of 1		
DATUM	AHD	LEVEL ORIGIN	-
CONTOURS	N/A	FILE NO.	BRSS7455-002-56-1
DRAWN	BJB	DATE	09/12/2019
CHECKED	RA	DATE	09/12/2019
APPROVED	RA	DATE	09/12/2019
PLAN NUMBER	BRSS7455-002-57-1		

© LandPartners 2019