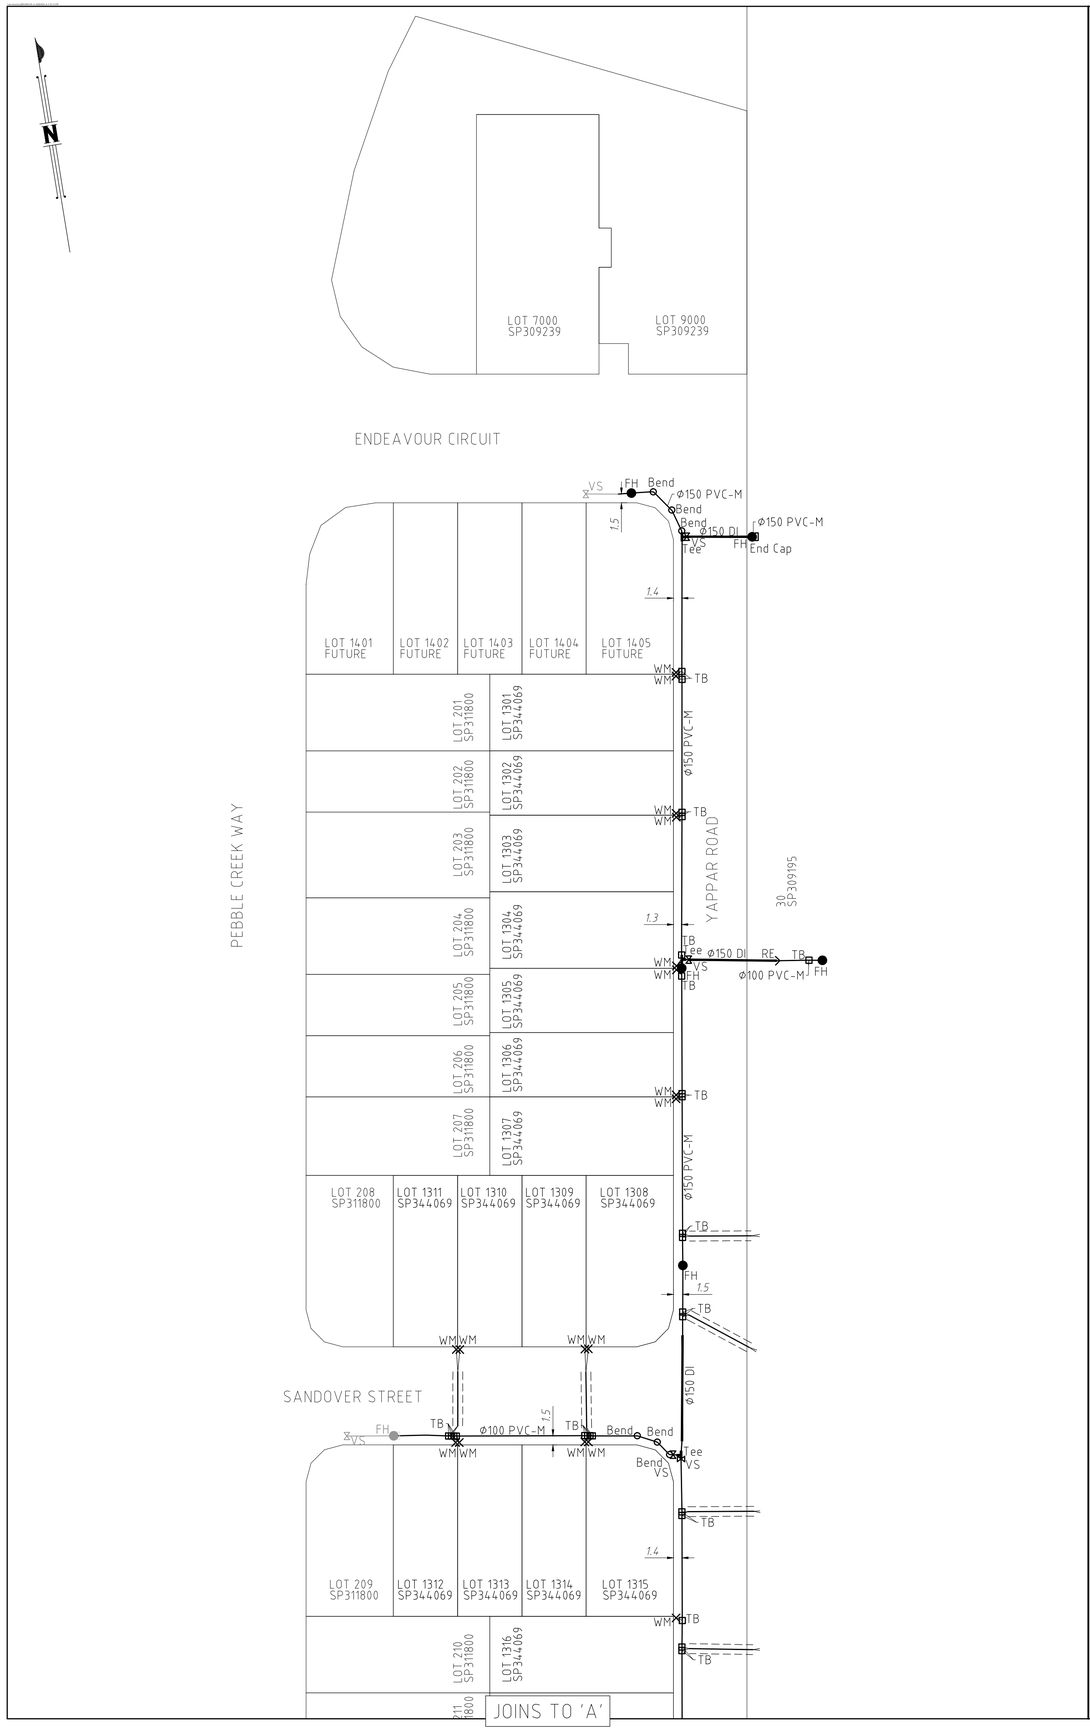

Consulting Engineer's Certification:

I, ... hereby certify that the As Constructed information shown on the plan is a true and correct record of the sizes, types, materials, classes etc., and it corresponds with the relevant approved Engineering Drawings.

Signed..... RPEQ No..... Dated.....

REGISTERED CADASTRAL SURVEYOR (QLD) CERTIFICATION:

LandPartners Pty Ltd, hereby certify that the horizontal and vertical locations, and dimensions shown on this plan are a true and correct record of the As Constructed information.

Signed... R. G. Andrew..... Date 20/08/2024
(Authorised Delegate)

LandPartners Pty Ltd, Registered Cadastral Surveyor SBQ ID 4118

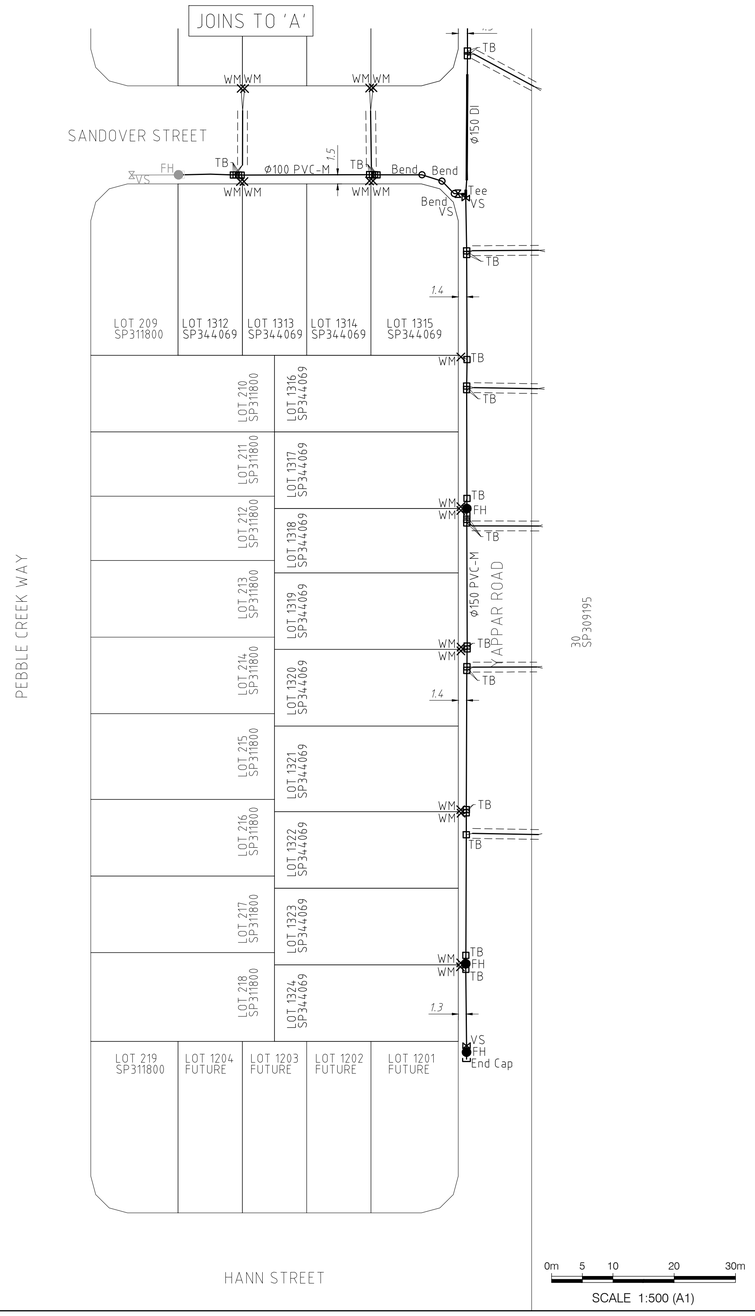

CLIENT

ORCHARD (PEBBLE CREEK) DEVELOPMENTS PTY LTD

PROJECT

AS CONSTRUCTED WATER

PEBBLE CREEK STAGE 13

DEV 2017 / 887

NOTES

- ALL WATER MAIN RETICULATION PIPES ARE PVC-M PN16 U.N.O.
- ALL WATER MAIN CROSSING PIPES ARE DICL PN35 U.N.O.
- ALL FIRE HYDRANTS ARE Ø100 SPRING U.N.O.
- ALL SERVICE CROSSING CONDUITS ARE Ø100 PVC-U PN9 U.N.O.

REV	DATE	DRAWN	CHECKED	APPROVED	APPROVED DATE
1	20/08/2024	BJB	RA	RA	21/08/2024

LANDPARTNERS surveyors and planners

Brisbane Office
Level 1
18 Little Cribb Street
Milton QLD 4064

PO Box 1399
Milton
QLD 4064

p: (07) 3842 1000
f: (07) 3842 1001
e: info@landpartners.com.au
w: www.landpartners.com.au

LEVEL DATUM	LOCAL AUTHORITY
AHD	LOGAN C.C.
LEVEL ORIGIN	CONTOUR INTERVAL
-	N/A
MERIDIAN	CO-ORD SYSTEM
MGA94	MGA ZONE 56

UDN SHEET 1 OF 1

BRSS7455-013-41-1

©LANDPARTNERS 2024